


**APPENDIX 7**  
**REFERENCE MATERIAL**





# Phase 1 – Cacouna Energy, Gros Cacouna, Quebec

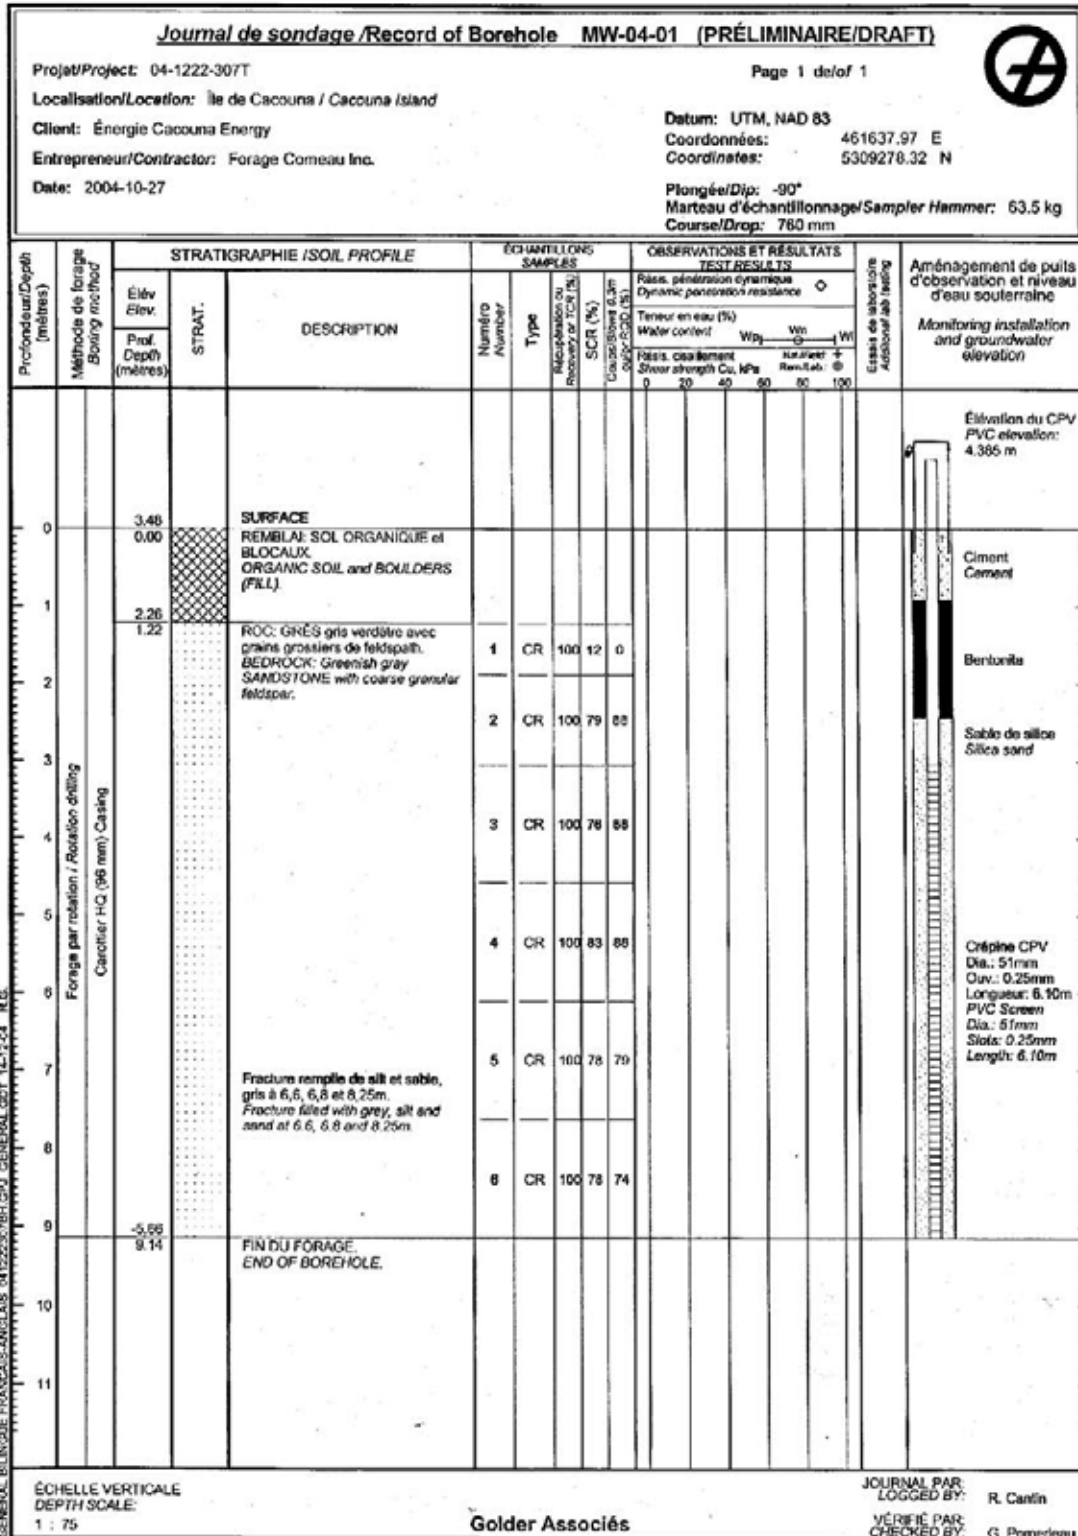

Monitoring Well Log MW-05-01 (Golder and Assoc., 2005)




S-05-1743, Oct. 2005





# Phase 1 – Cacouna Energy, Gros Cacouna, Quebec

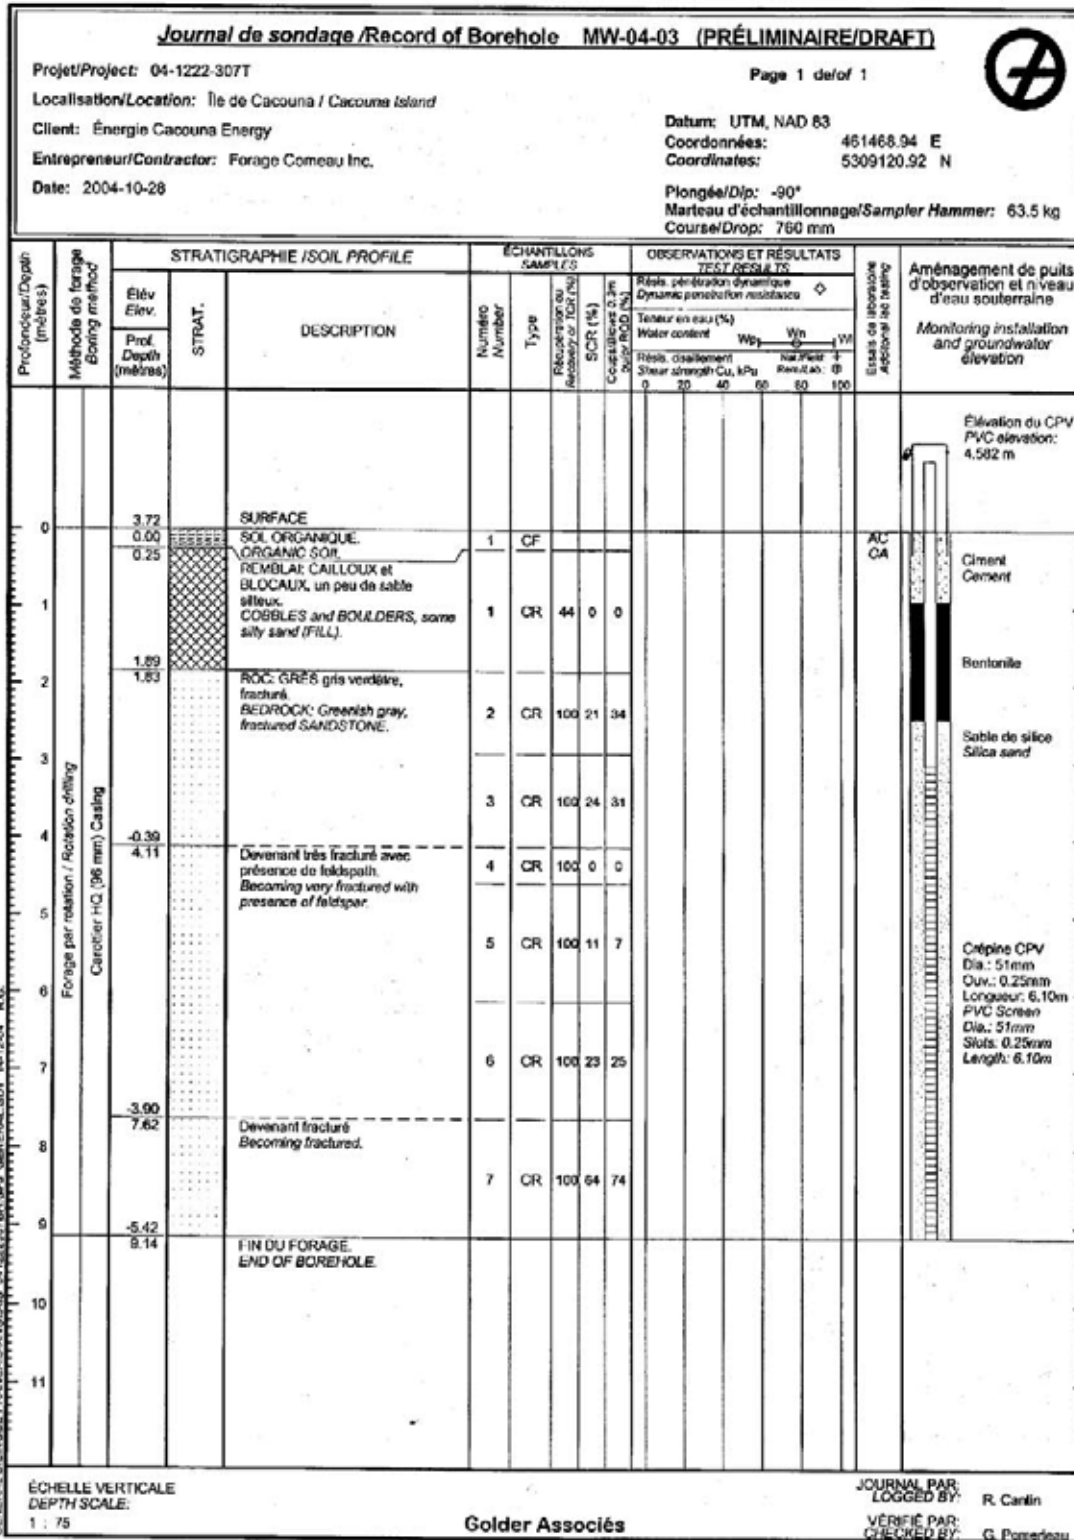


Monitoring Well Log MW-05-03 (Golder and Assoc., 2005)



S-05-1743, Oct. 2005

# Phase 1 – Cacouna Energy, Gros Cacouna, Quebec

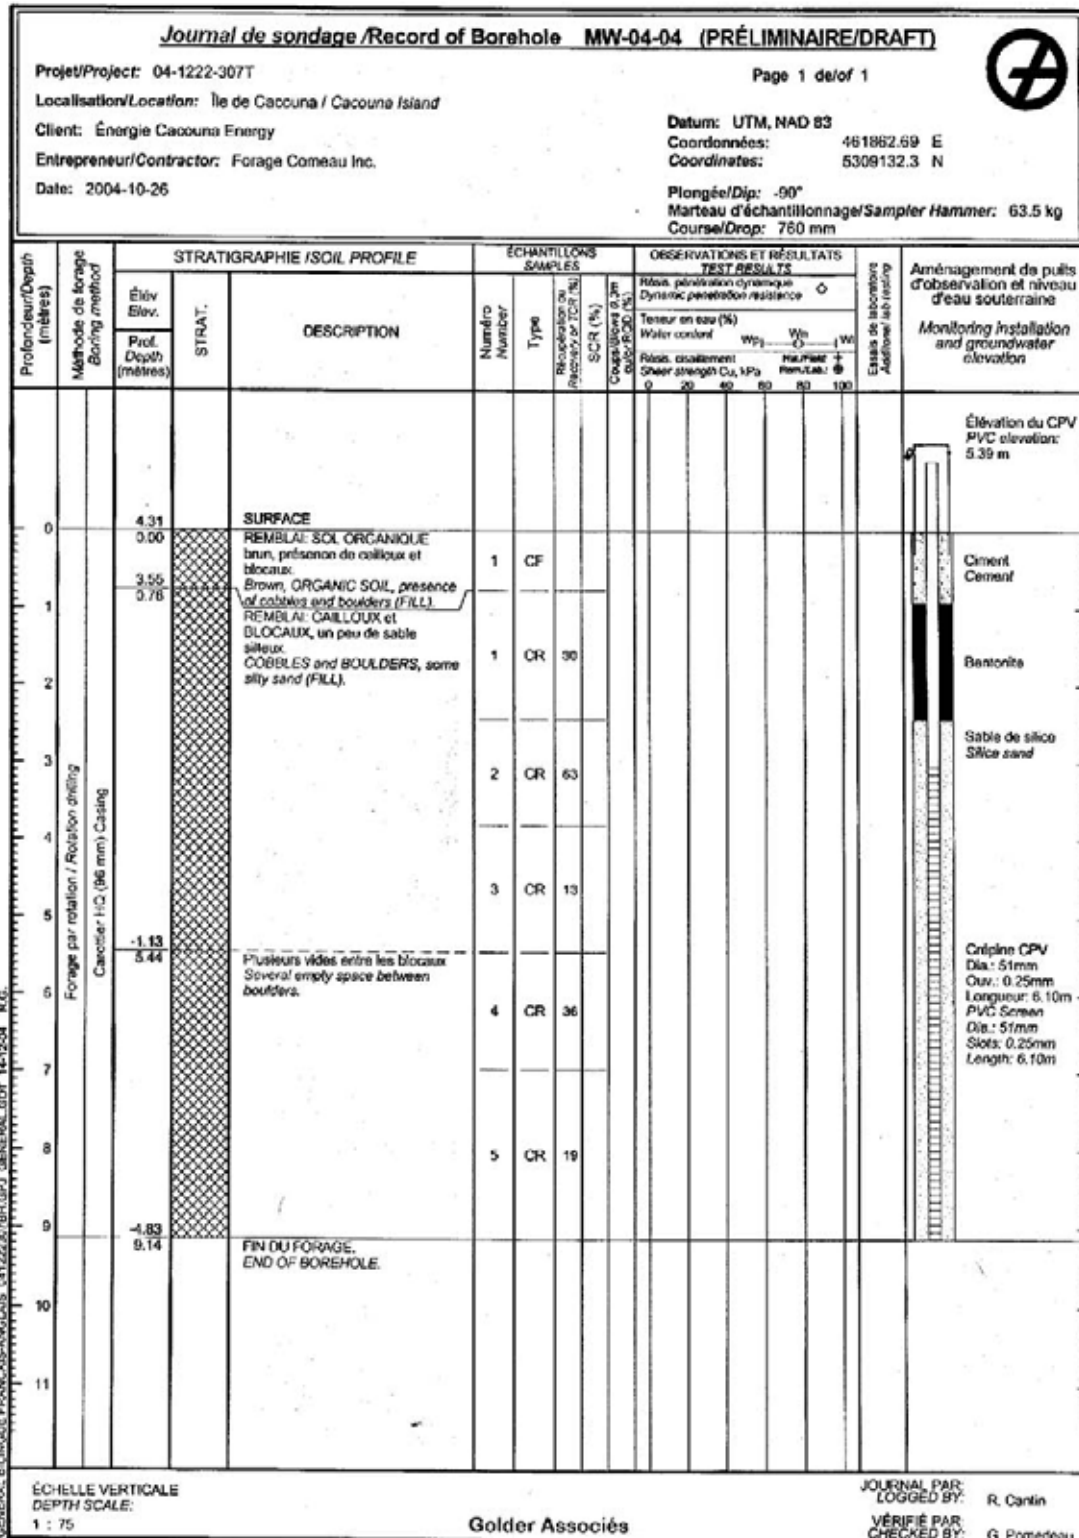


Monitoring Well Log MW-05-04 (Golder and Assoc., 2005)



S-05-1743, Oct. 2005

# Phase 1 – Cacouna Energy, Gros Cacouna, Quebec

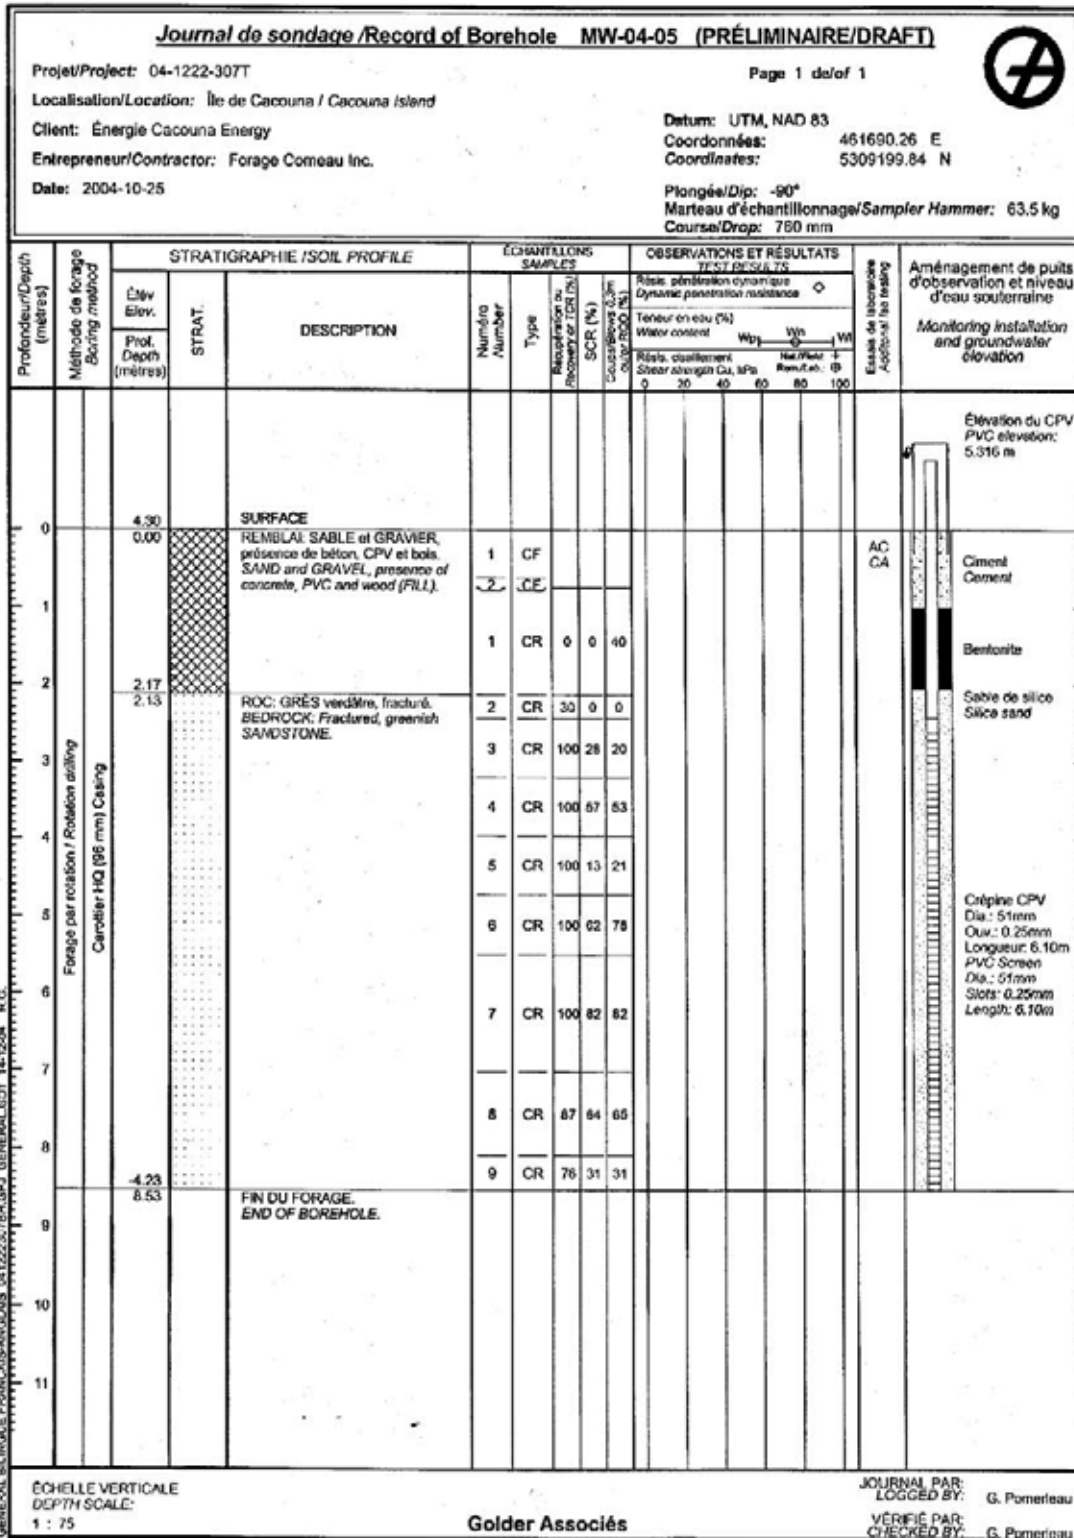

Monitoring Well Log MW-05-05 (Golder and Assoc., 2005)



S-05-1743, Oct. 2005