



DRAINAGE AGRICOLE

Cas type #1

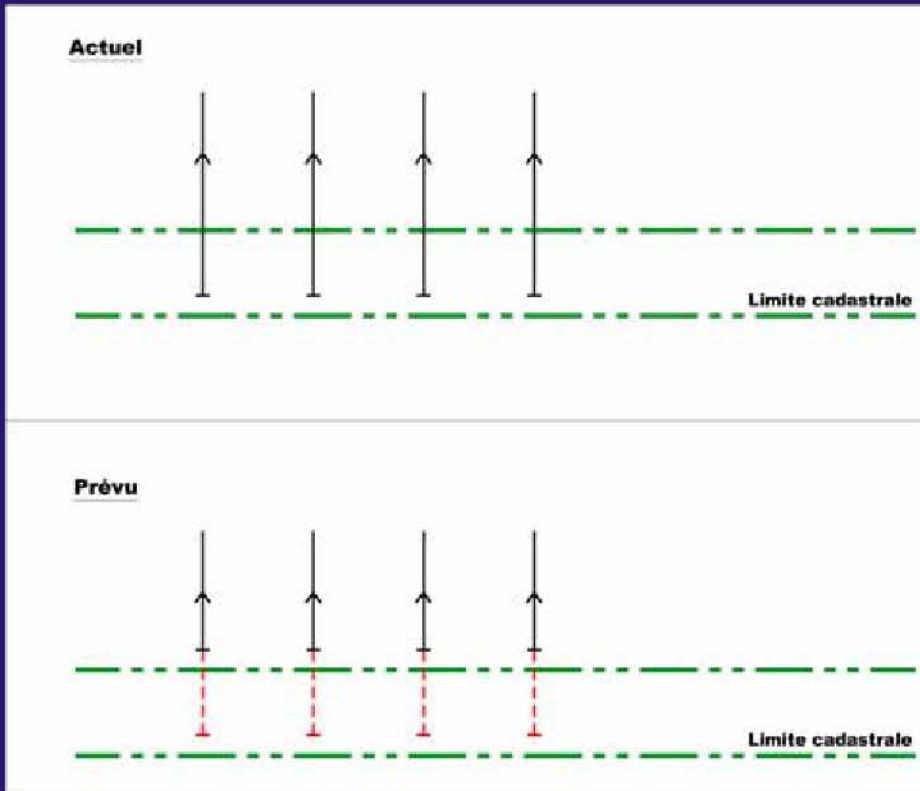


DRAINAGE AGRICOLE

Cas type #2

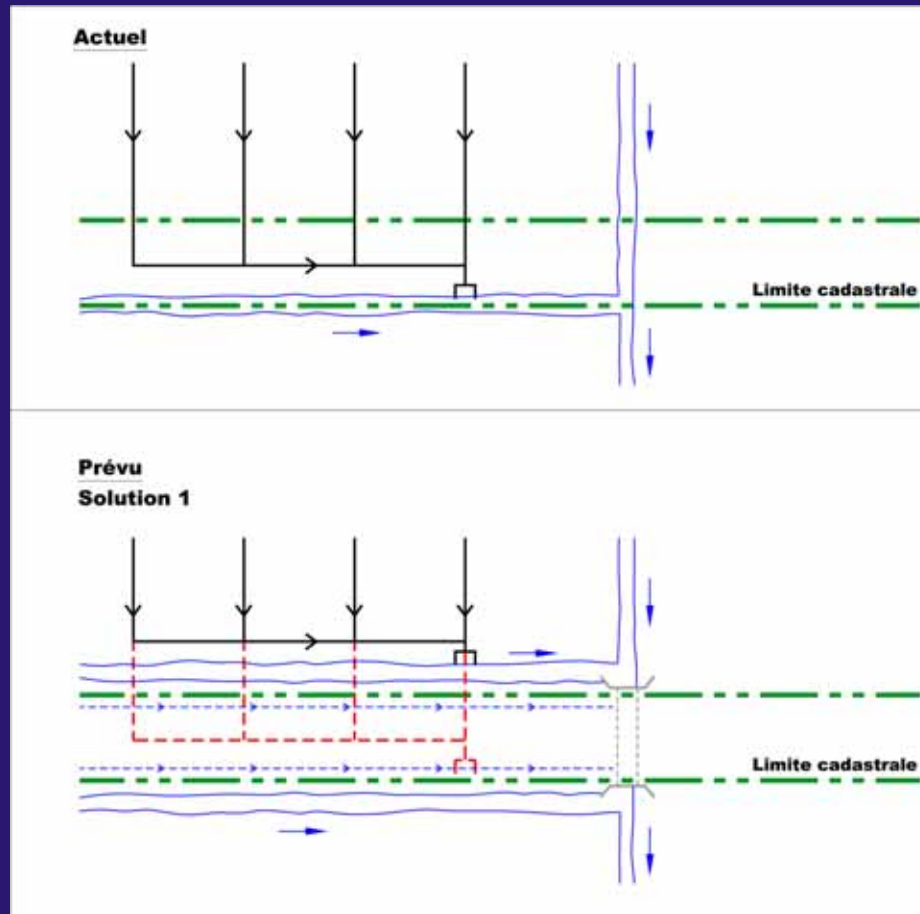


DRAINAGE AGRICOLE

Cas type #2

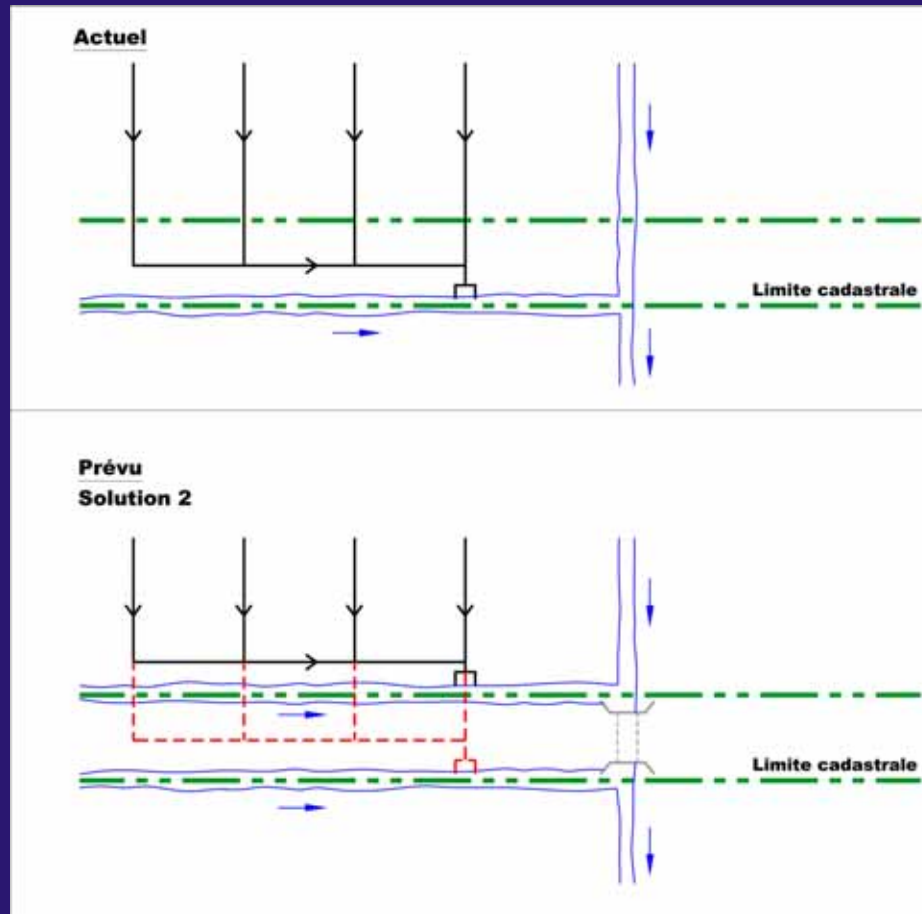

DRAINAGE AGRICOLE

Cas type #2

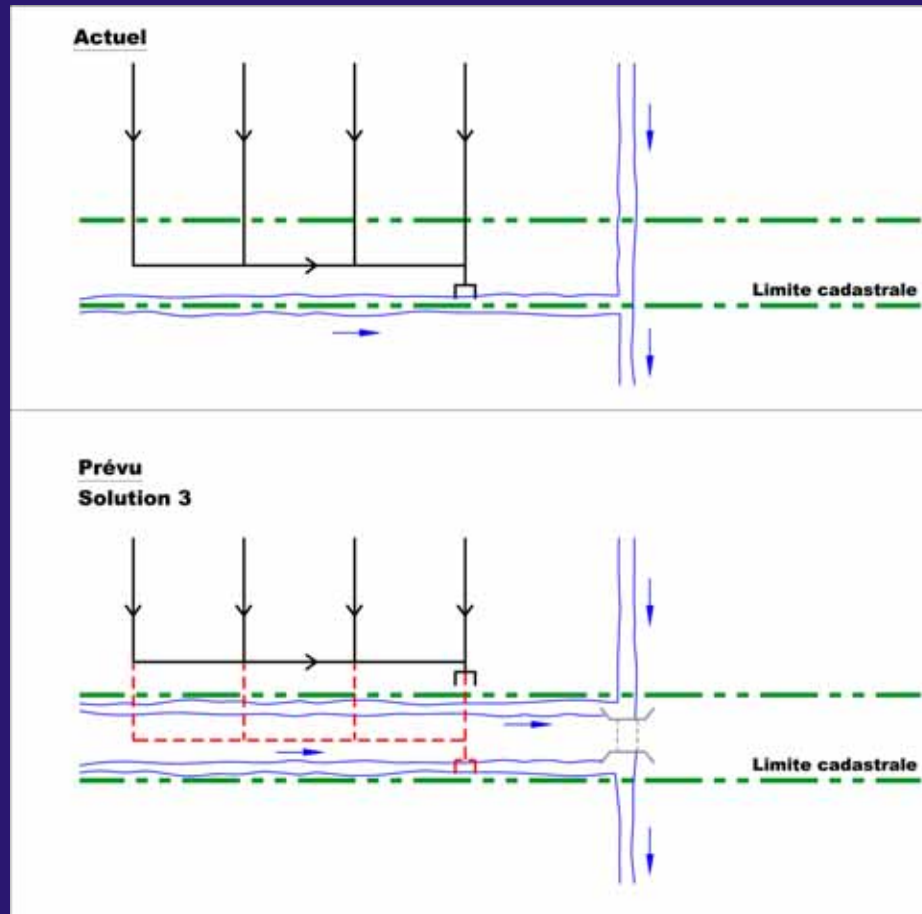

DRAINAGE AGRICOLE

Cas type #3

