




---

---

---

---

---

---

---

---




---

---

---


---

---

---

---

---

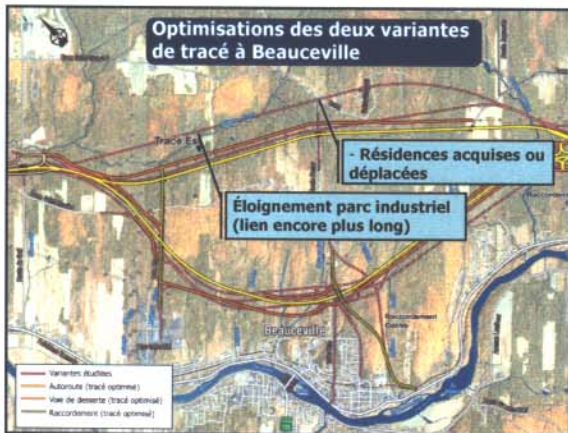


---

---

---


---

---

---

---

---

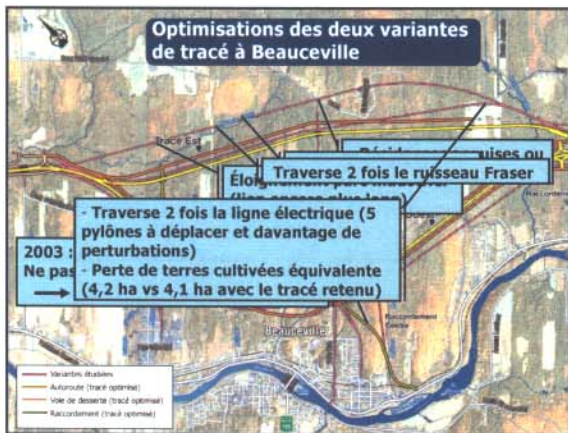


---

---

---


---

---

---

---

---

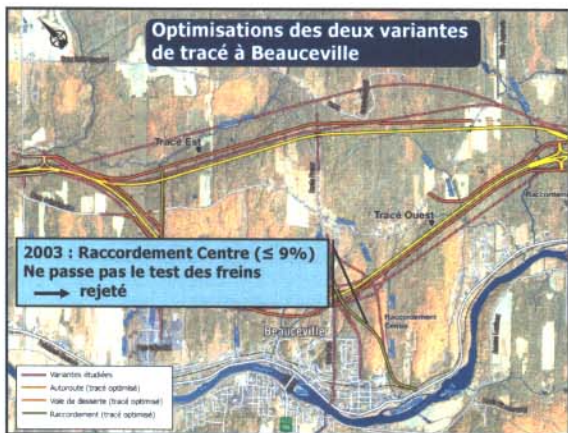


---

---

---


---

---

---

---

---

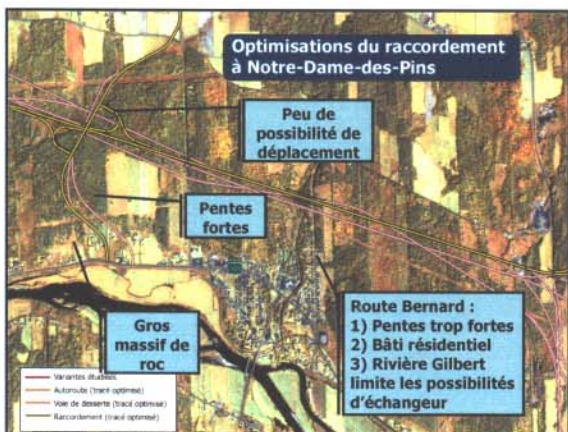


---

---

---

---

---

---

---

---




---

---

---


---

---

---

---

---

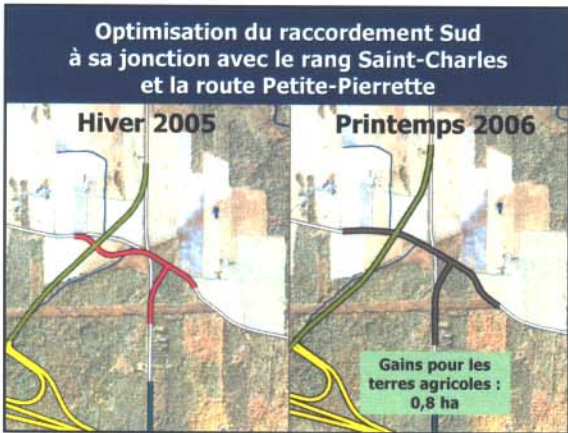


---

---

---

---

---

---

---

---