
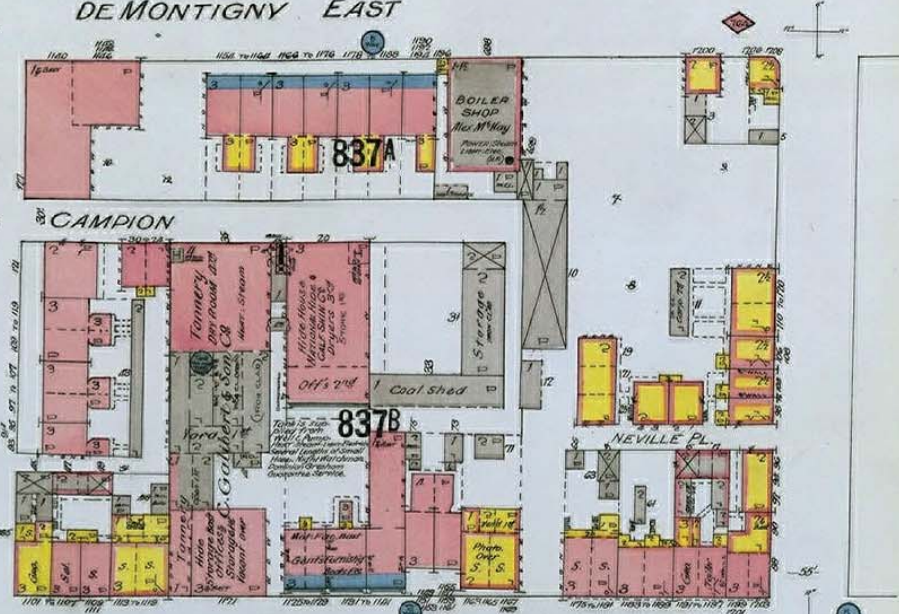
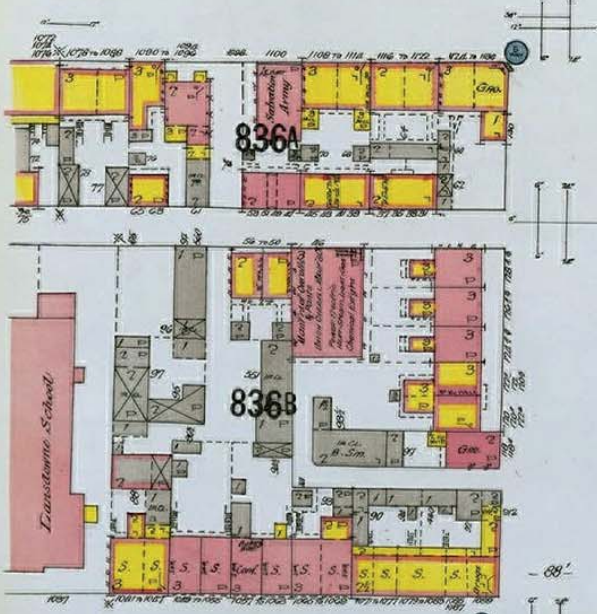
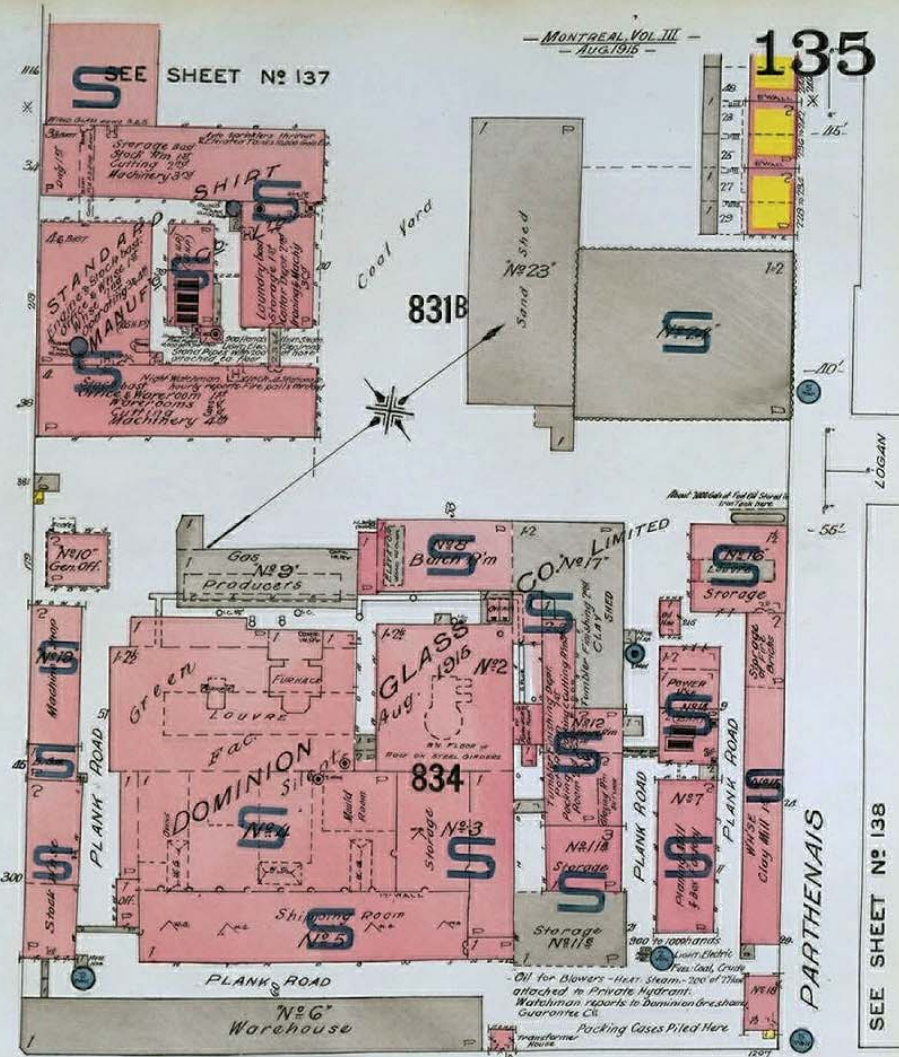


ANNEXE E
Plans d'assurance-incendie

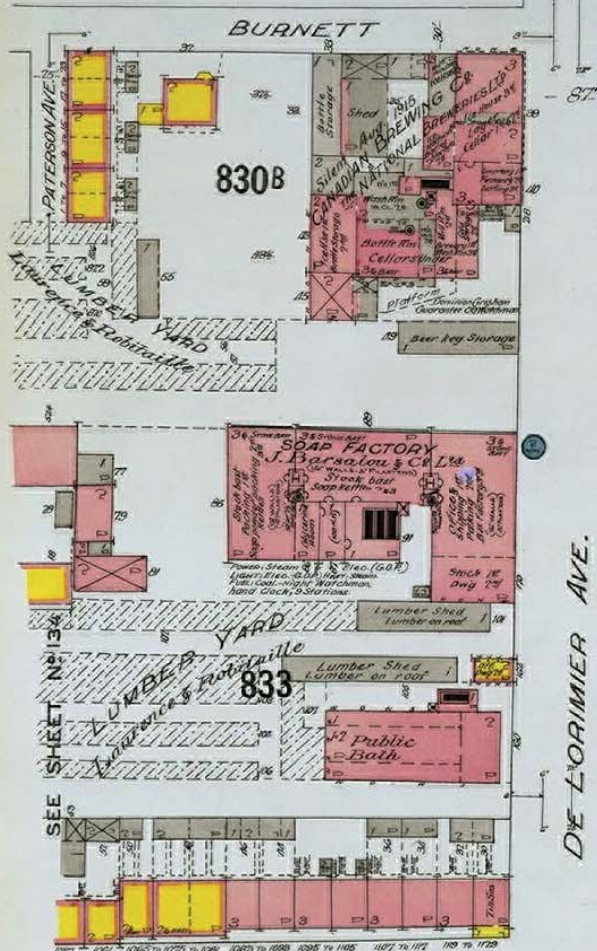


ST. CATHERINE EAST

SEE SHEET N° 114

SCALE 50 FT. = 1 INCH

SEE SHEET N° 138

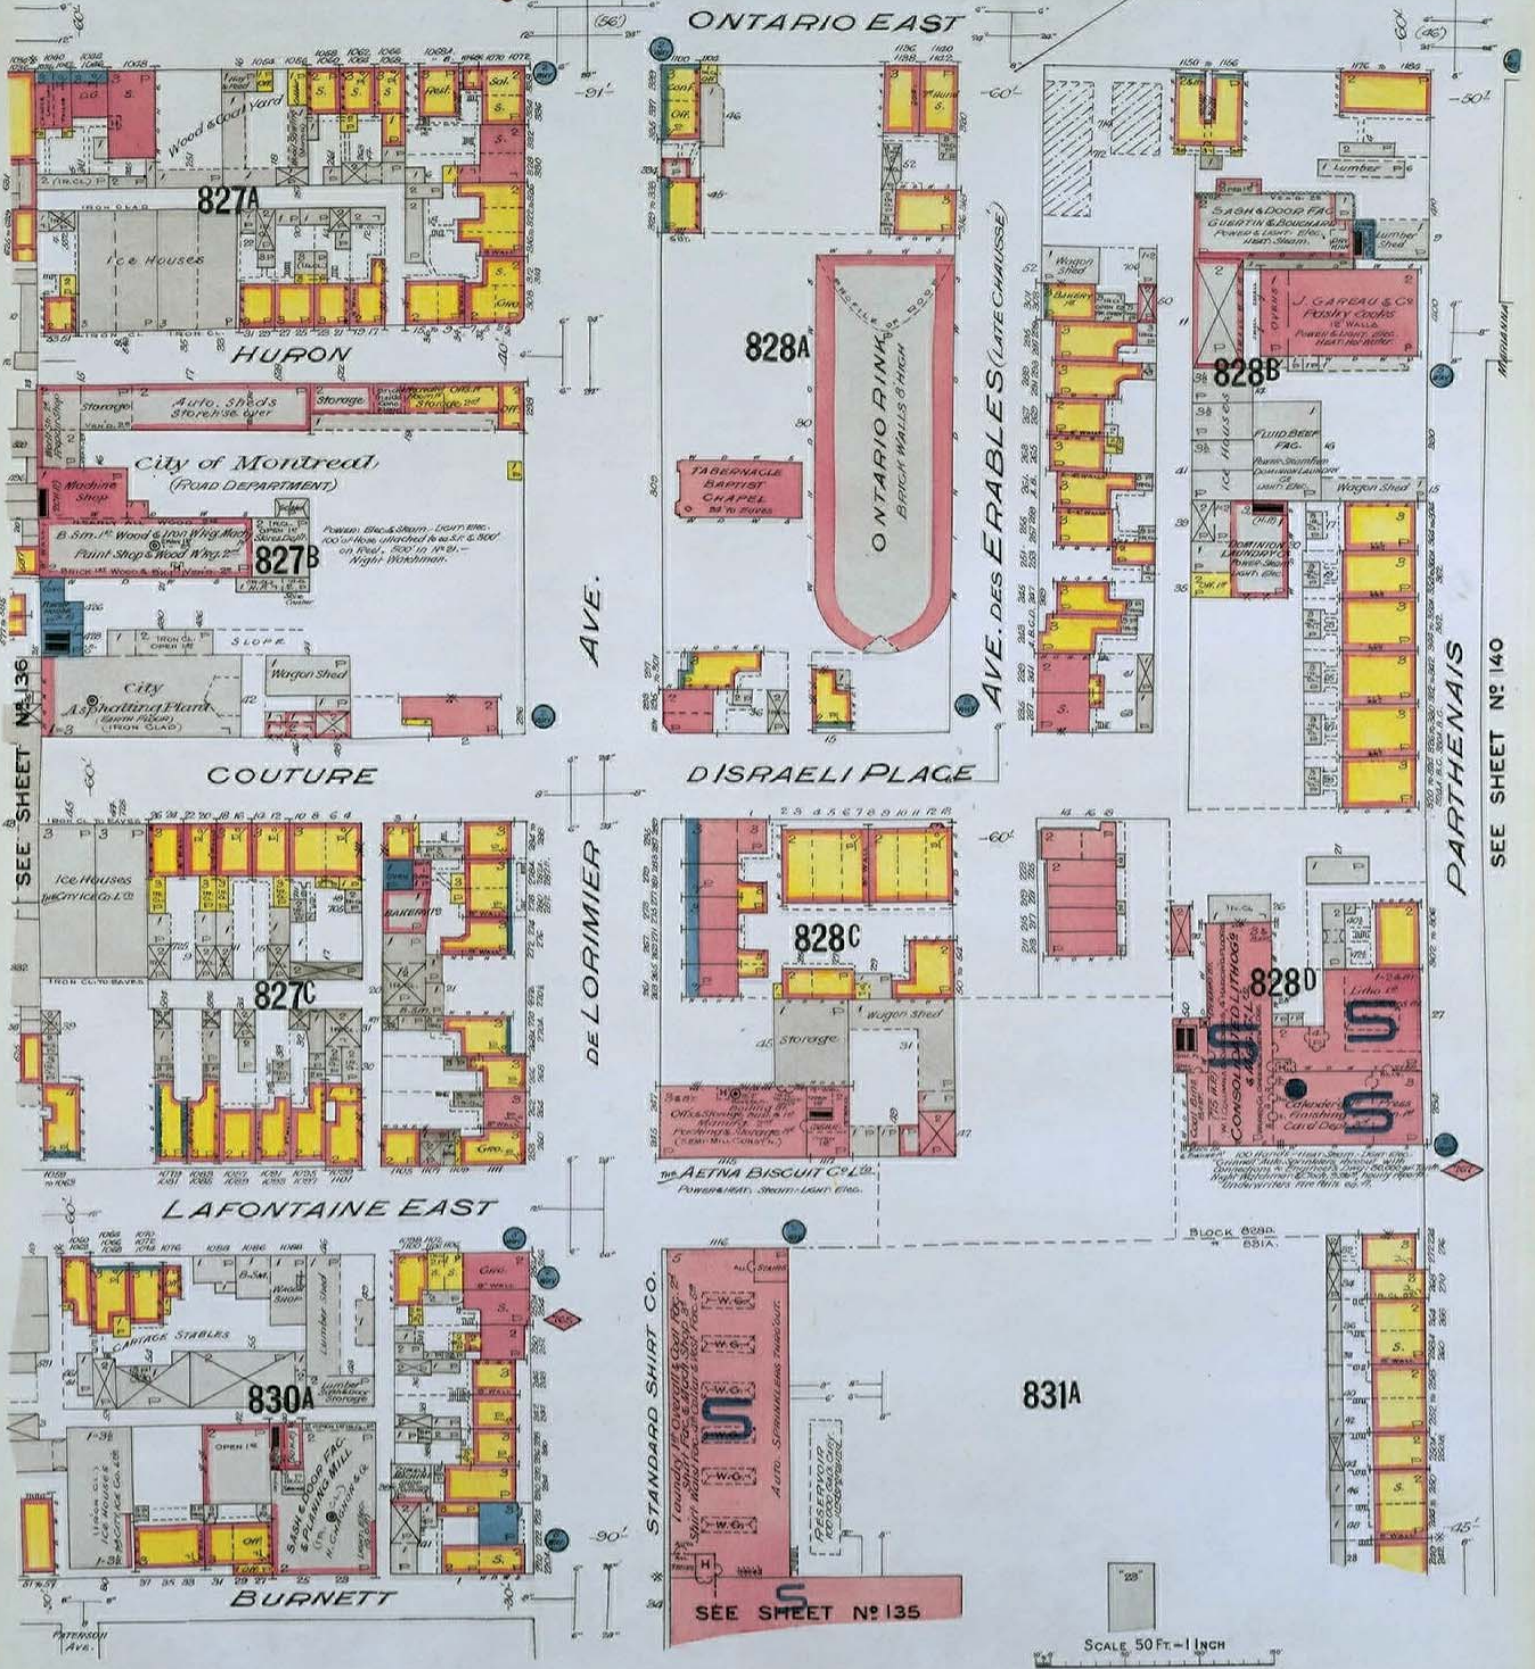

SEE SHEET N° 136


SEE SHEET N° 140

SCALE 50 FT. = 1 INCH


MONTREAL VOL. III
- AUG. 1915

ONTARIO EAST

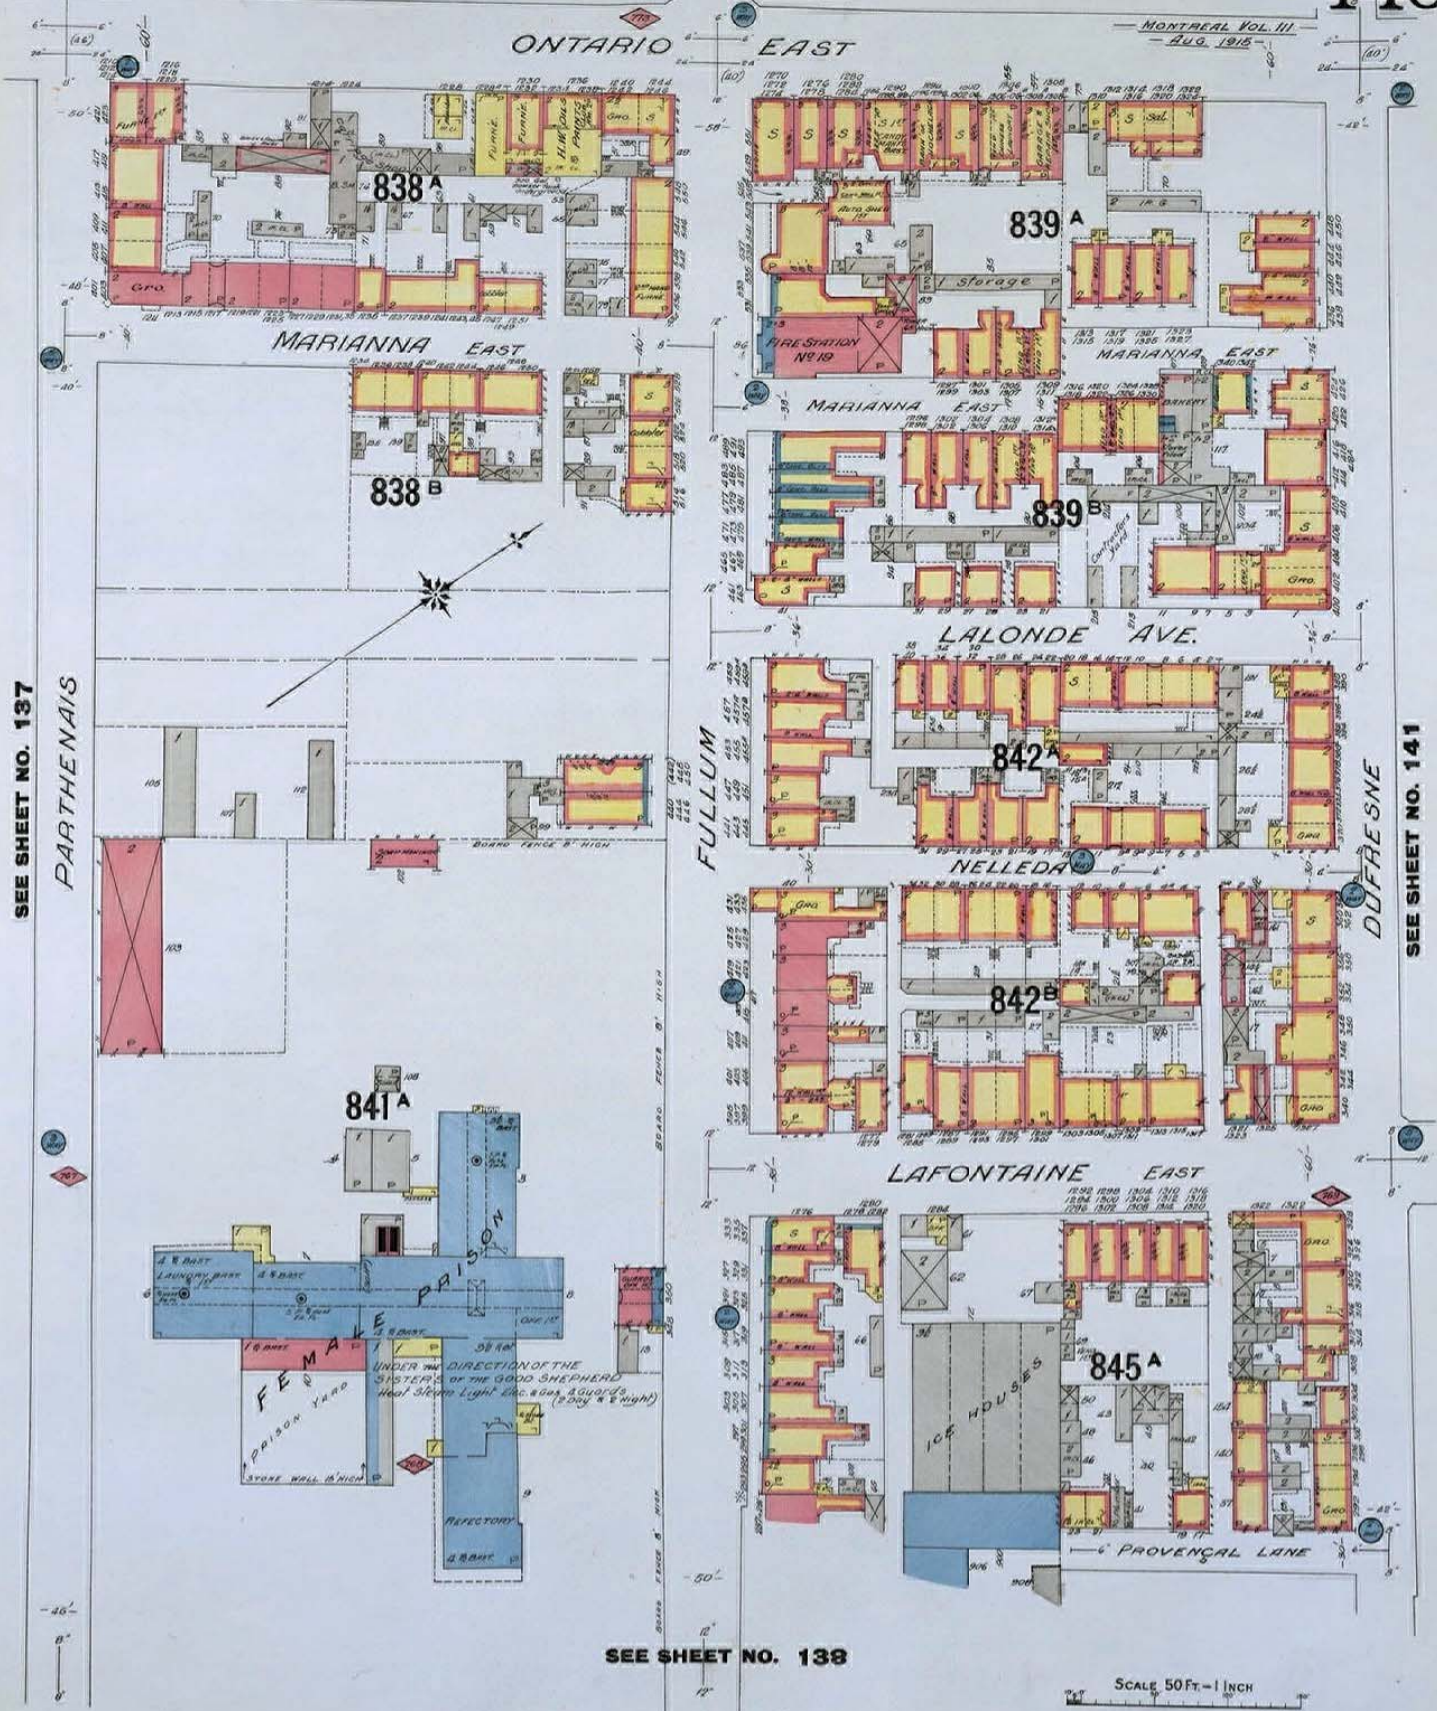

SEE SHEET NO. 137

PARTHENAIS


FULLUM

DUFRESNE

SEE SHEET NO. 141

SEE SHEET NO. 138

SCALE 50 FT. = 1 INCH

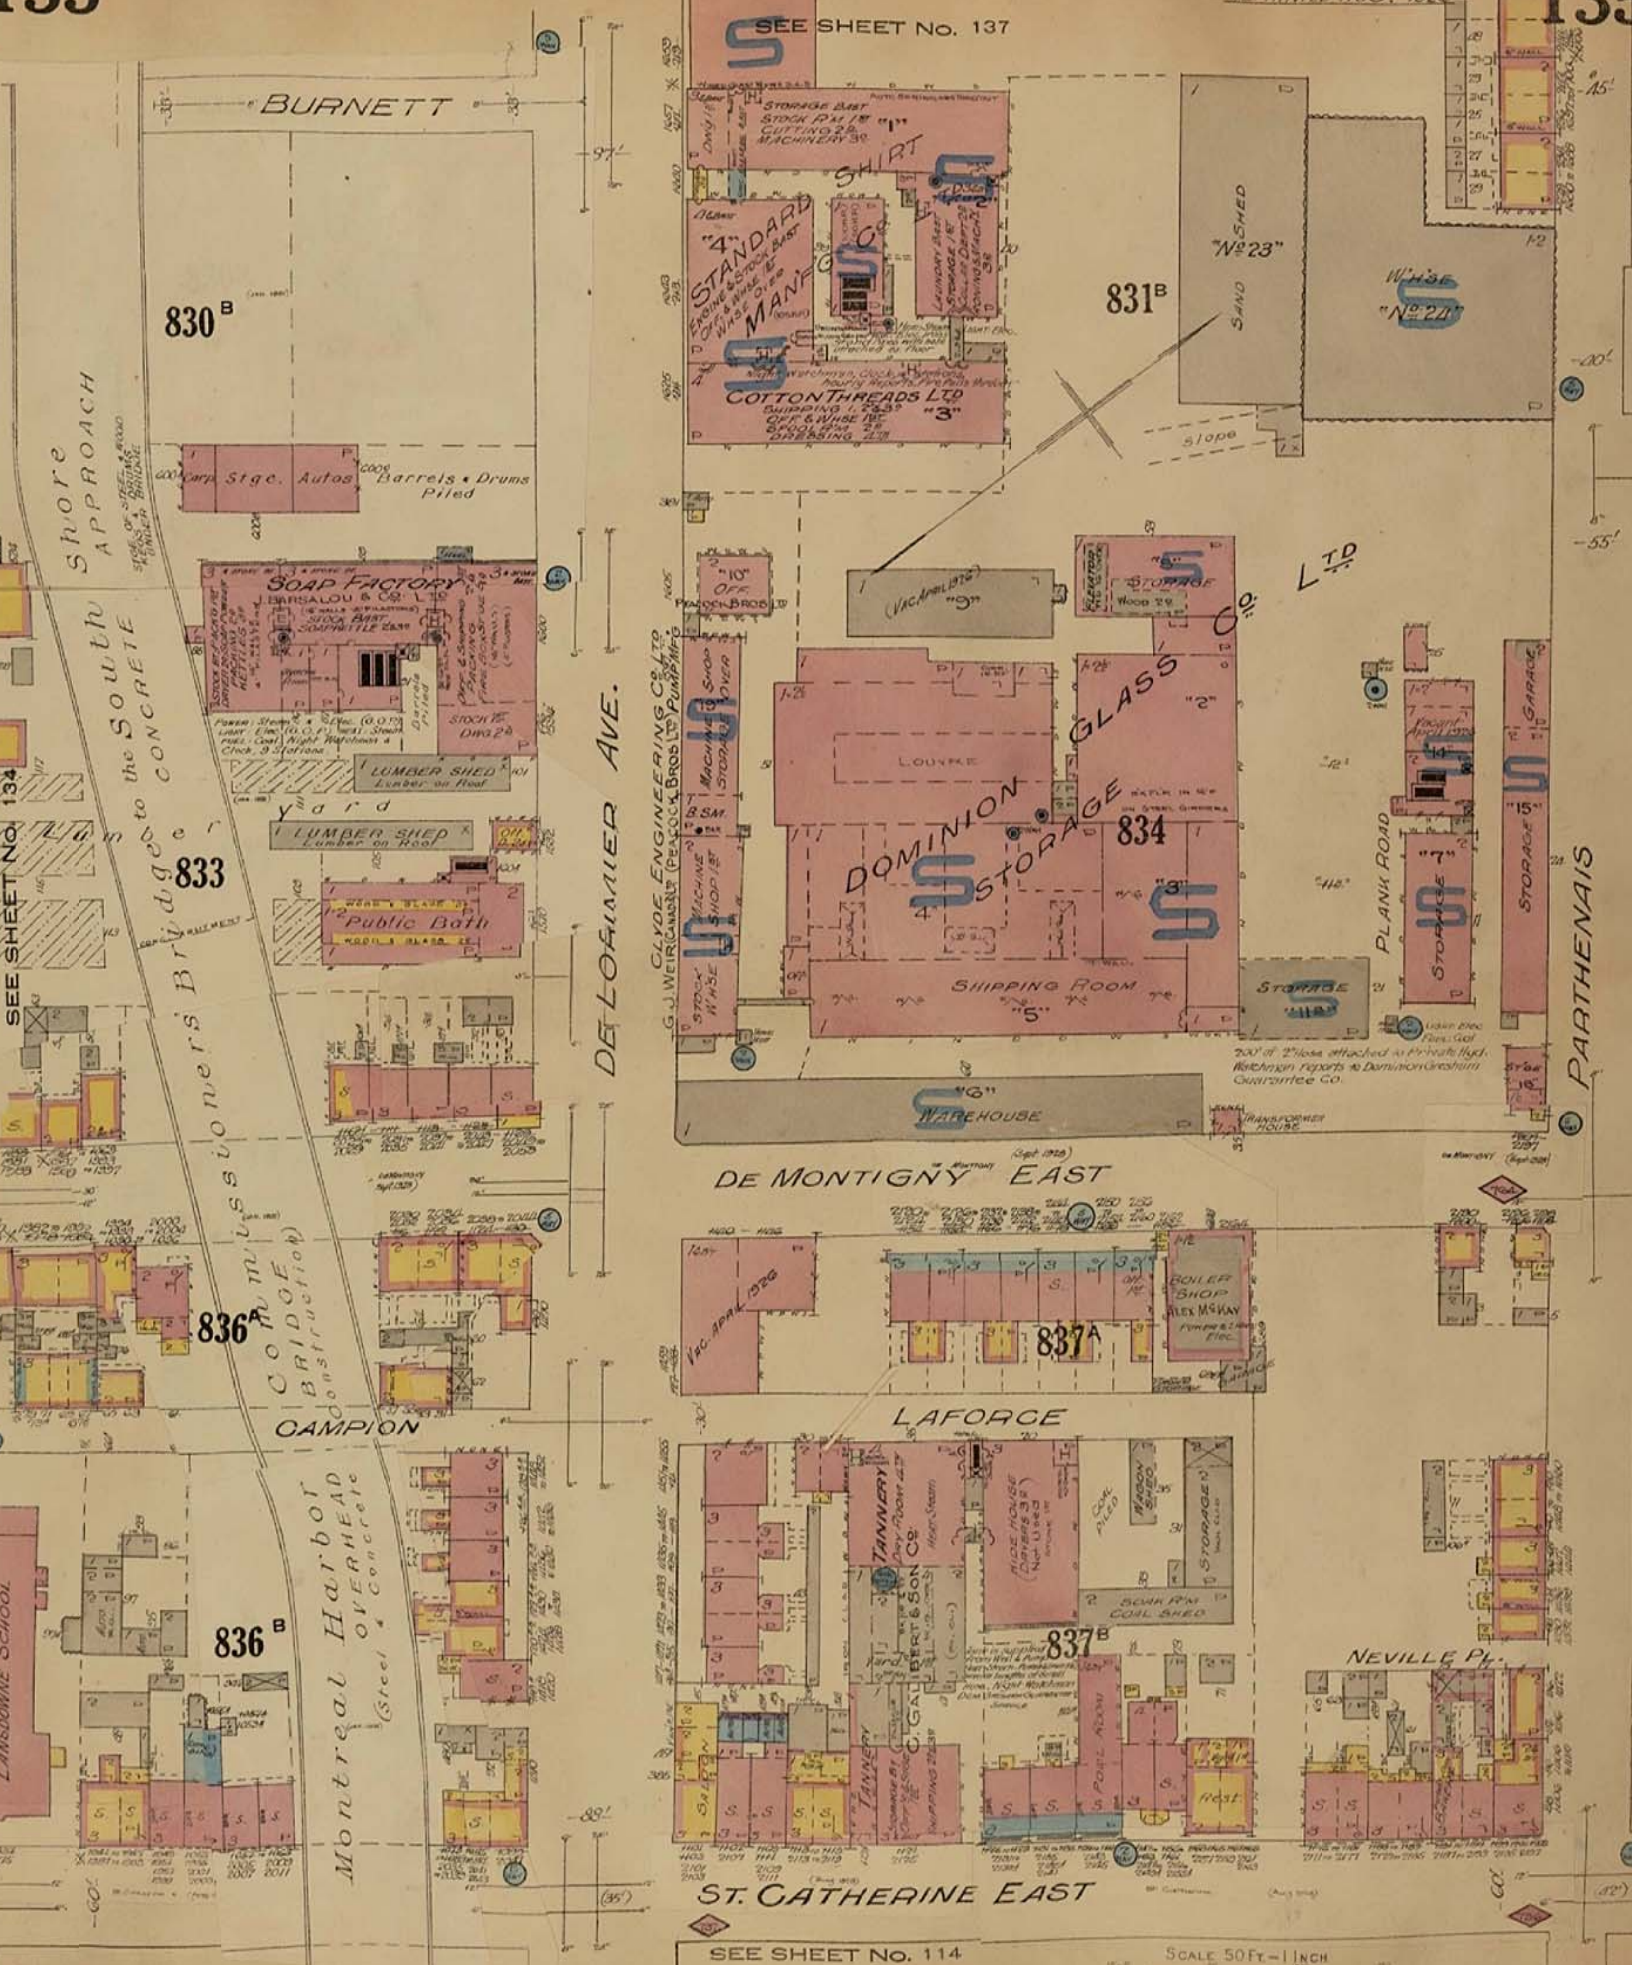



SEE SHEET NO. 136

SEE SHEET NO 140

SEE SHEET NO 135

SCALE 50 FT = 1 INCH

MONTREAL VOL. III
- JULY 1915
- REVISED AUG. 1915


SEE SHEET NO. 137

PARTHENAIS

SEE SHEET NO. 141

DUFRESNE


FULLUM

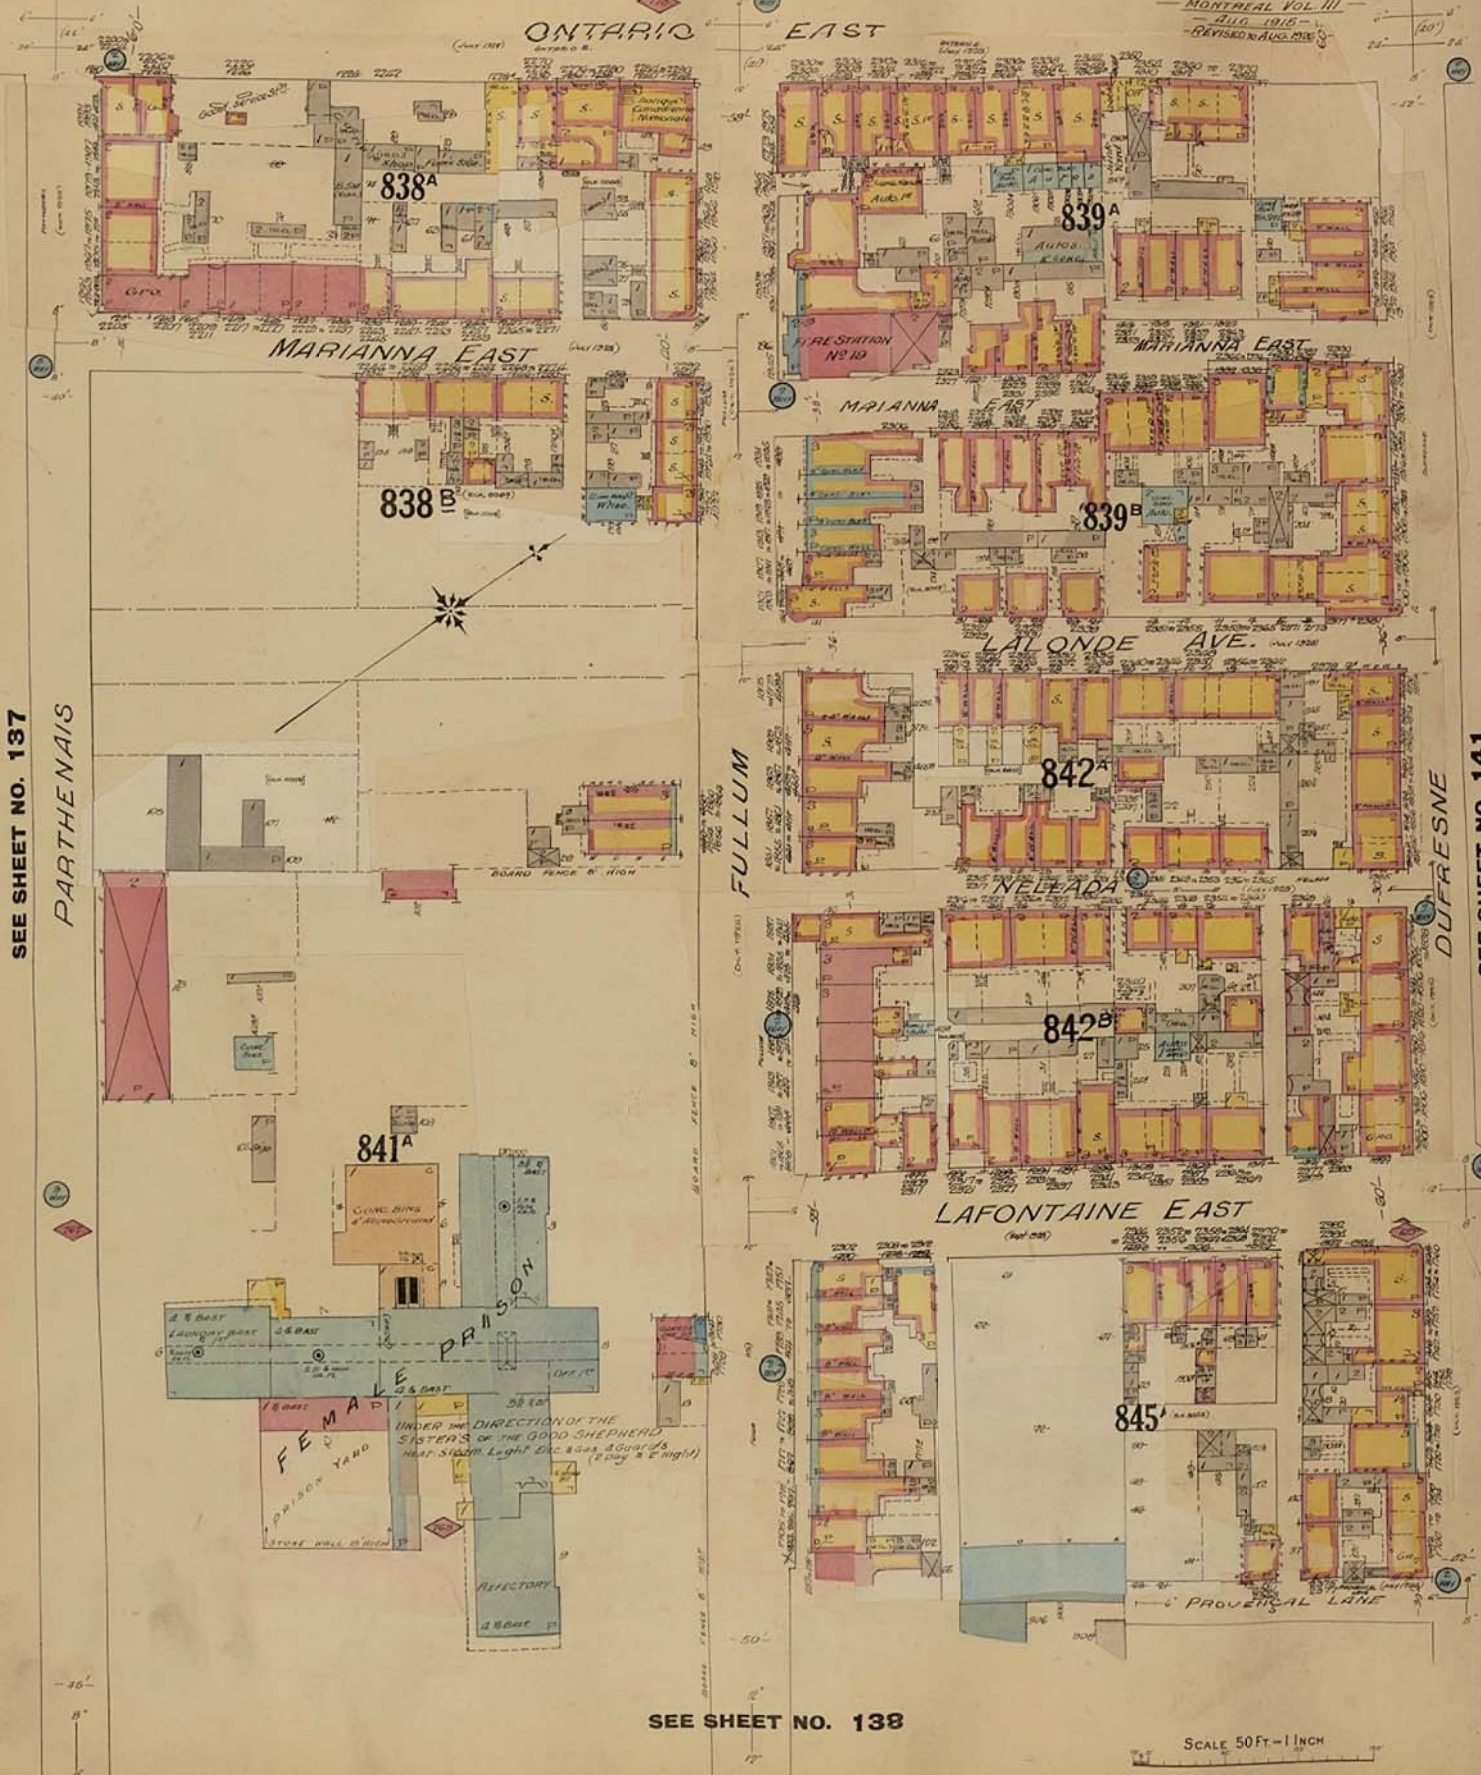

This plan is the property of the UNDERWRITERS' SURVEY BUREAU, LIMITED. (Unauthorized reproduction prohibited) and is loaned on the following conditions: that the plan is to be kept in good order, that it be not used in connection with business of Companies, Members of the Canadian Fire Underwriters' Association, and it to be returned on request to the UNDERWRITERS' SURVEY BUREAU, LIMITED, Toronto and Montreal.


COPYRIGHT REGISTERED AT OTTAWA BY THE UNDERWRITERS SURVEY BUREAU, LIMITED MONTREAL AND TORONTO


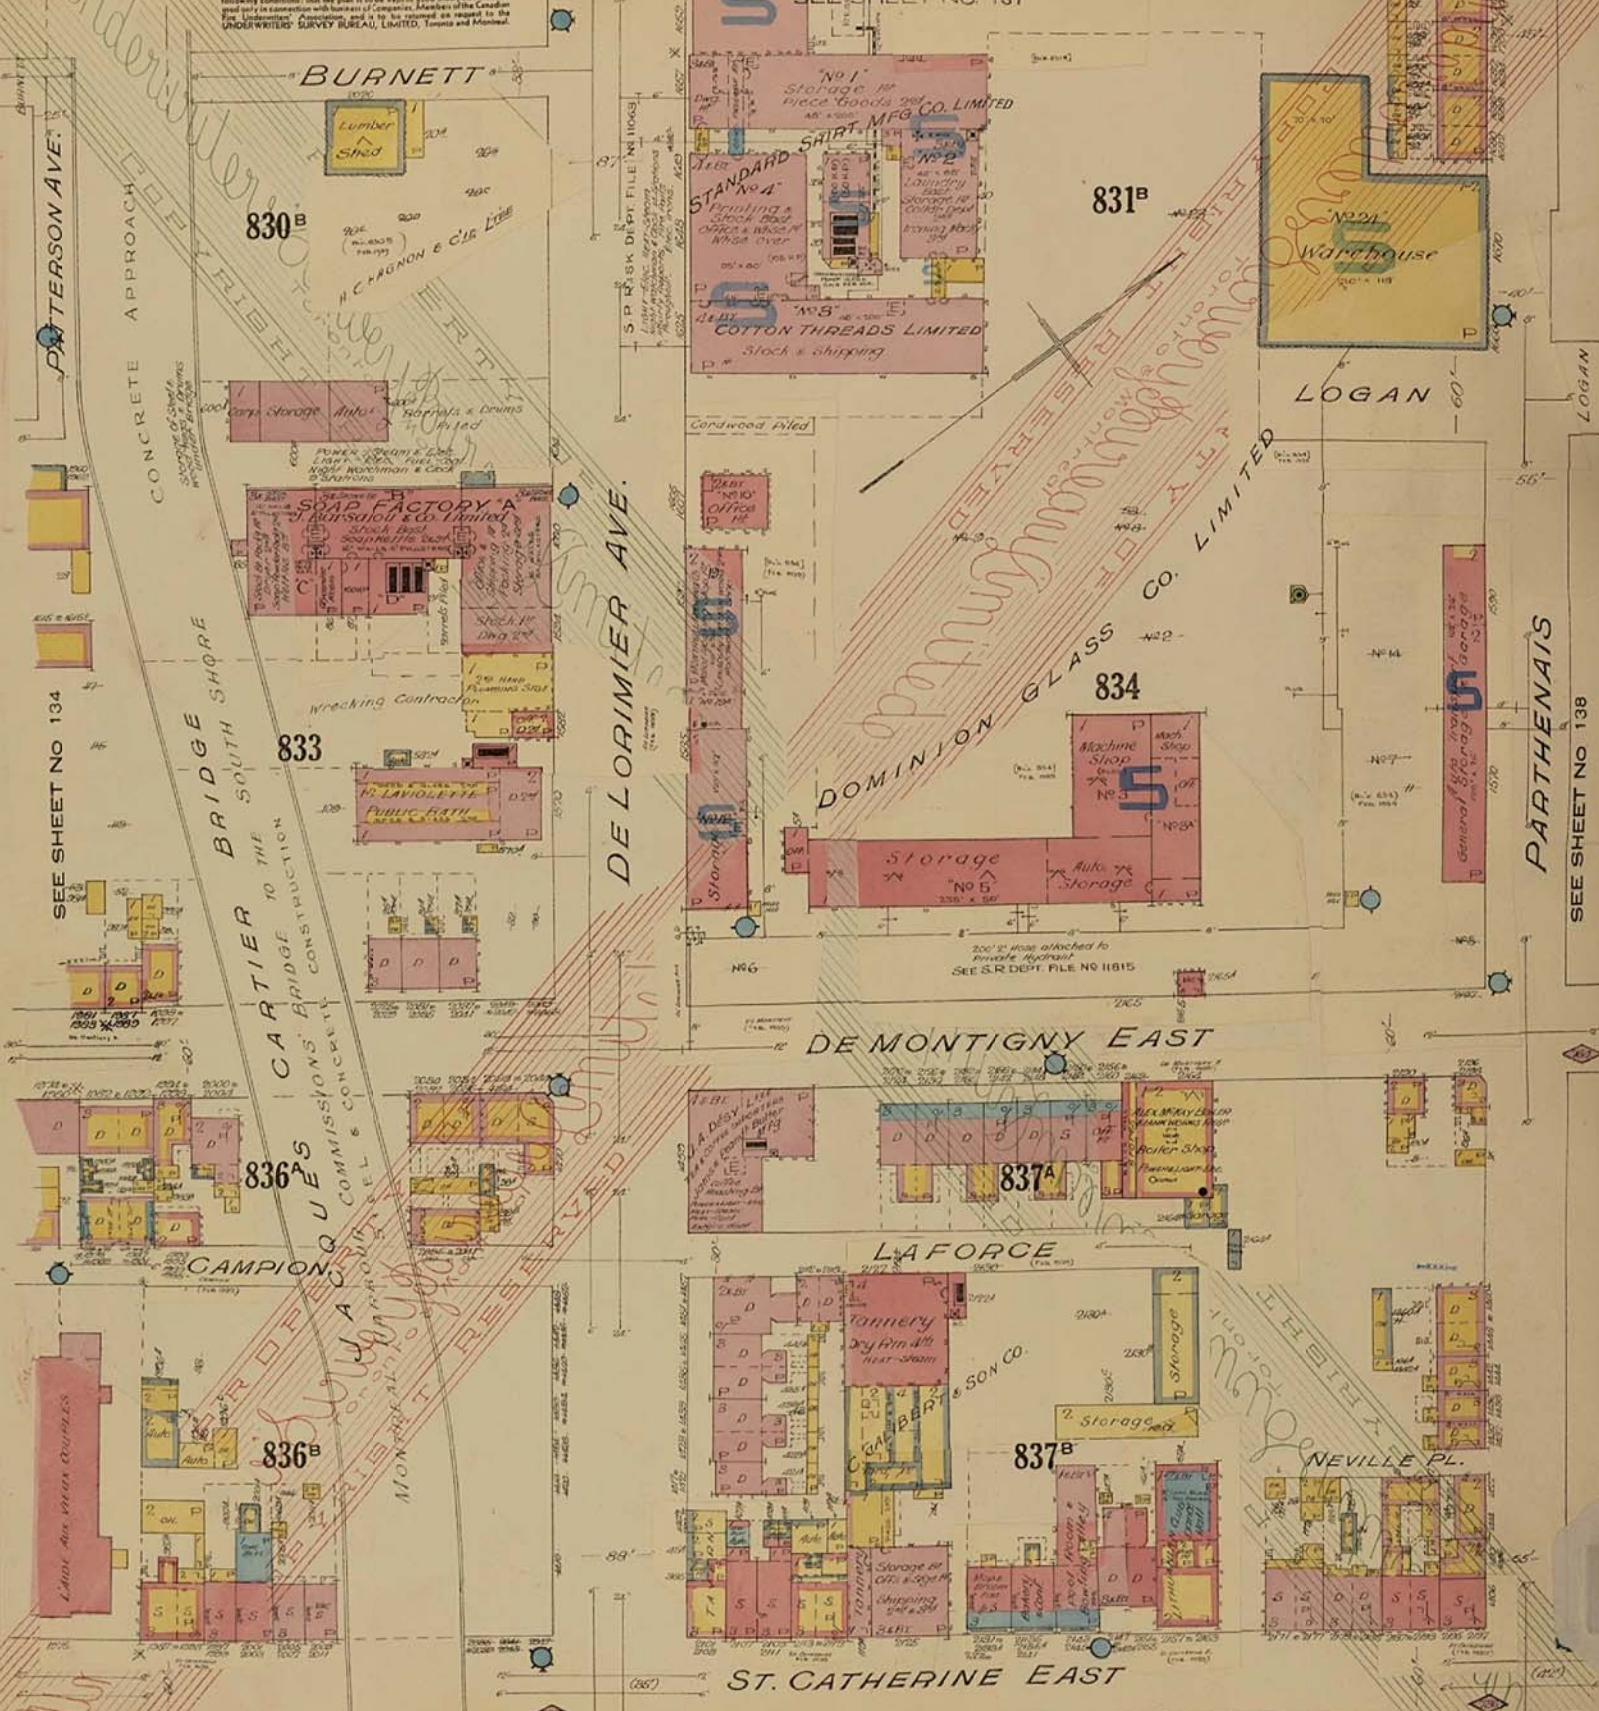

137

137

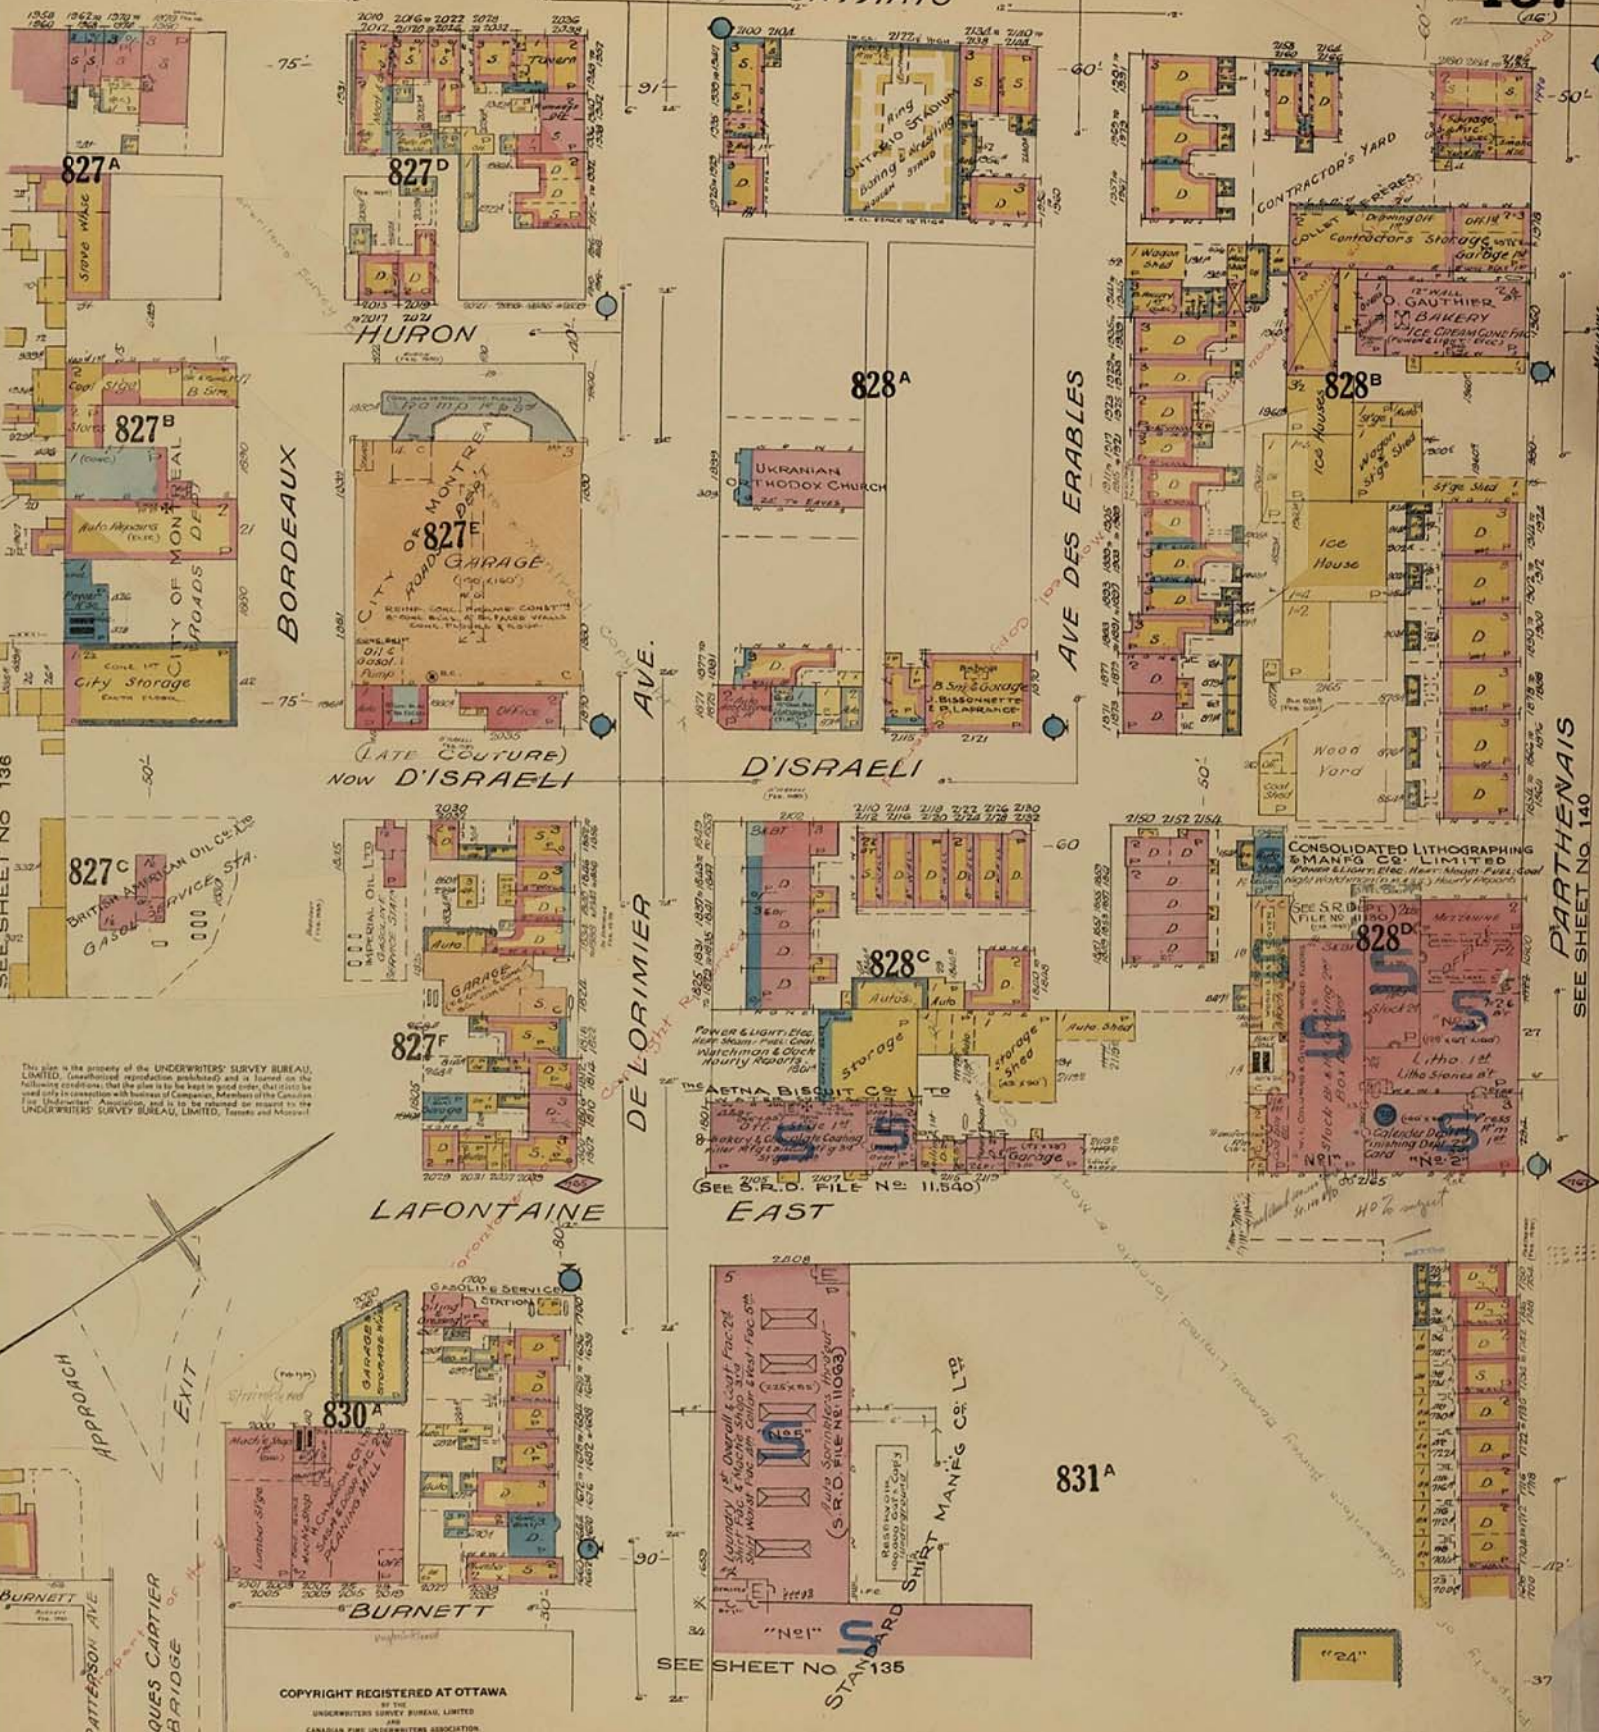

This plan is the property of the UNDERWRITERS' SURVEY BUREAU, LIMITED. (Unauthorized reproduction prohibited) and is loaned on the following conditions: that the plan is to be kept in good order, that it is to be used only in connection with business of Companies, Members of the Canadian Fire Underwriters' Association, and is to be returned or sent to the UNDERWRITERS' SURVEY BUREAU, LIMITED, Toronto and Montreal.

COPYRIGHT REGISTERED AT OTTAWA
BY THE
UNDERWRITERS' SURVEY BUREAU, LIMITED
AND
CANADIAN FIRE UNDERWRITERS' ASSOCIATION

SCALE 50 FT. = 1 INCH

SEE SHEET NO 136

SEE SHEET NO 140

SEE SHEET No 135


37

This plan is the property of the UNDERWRITERS' SURVEY BUREAU, LIMITED, (reproduction prohibited) and is loaned on the following conditions: that the plan is to be kept in good order, that it is to be used only in connection with business of Companies, Members of the Canadian Fire Underwriters' Association, and it is to be returned on request to the UNDERWRITERS' SURVEY BUREAU, LIMITED, Toronto and Montreal.

SEE SHEET No. 151

MONTREAL, VOL. III
JAN. 1935
REVISED 10 FEB. 1939

ONTARIO EAST

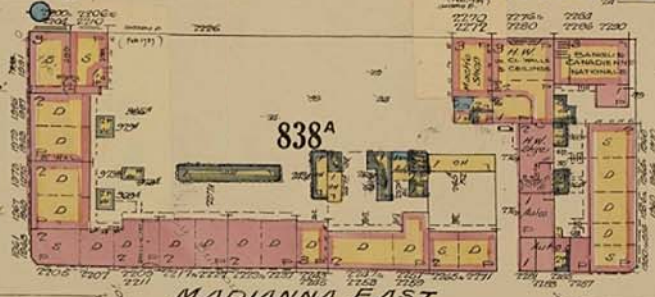


838^A

MARIANNA EAST



838^B

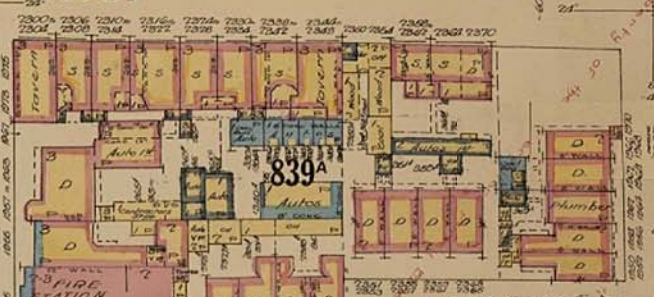

839^A

MARIANNA EAST



839^B

LALONDE AVE.




842^A




842^B

LAFONTAINE EAST

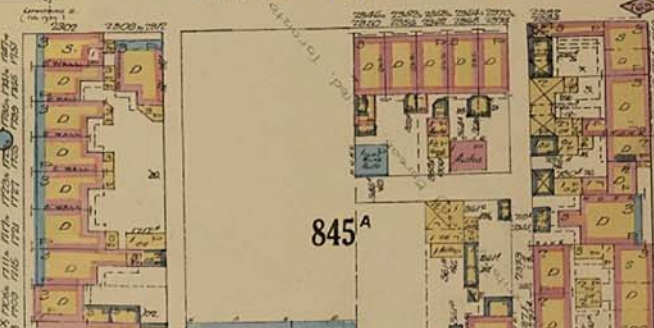

845^A

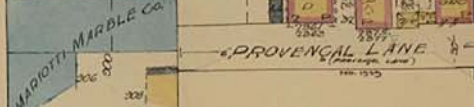

ASILE FEMALE PRISON
Under the direction of the SISTERS OF THE GOOD SHEPHERD
Heat, Steam, Light, Elec. 4 Guards
Power, Elec. 22 day & 2 night

LAUNDRY

PRISON YARD

Chapel

MARIOTTI MARBLE CO.

COPYRIGHT REGISTERED AT OTTAWA
BY THE
UNDERWRITERS SURVEY BUREAU, LIMITED
MONTREAL AND TORONTO

SEE SHEET No. 138

SCALE 50 FT. = 1 INCH

SEE SHEET No. 137

PARTHENAIS

LAFONTAINE EAST


FULLUM

DUFRESNE

SEE SHEET No. 141




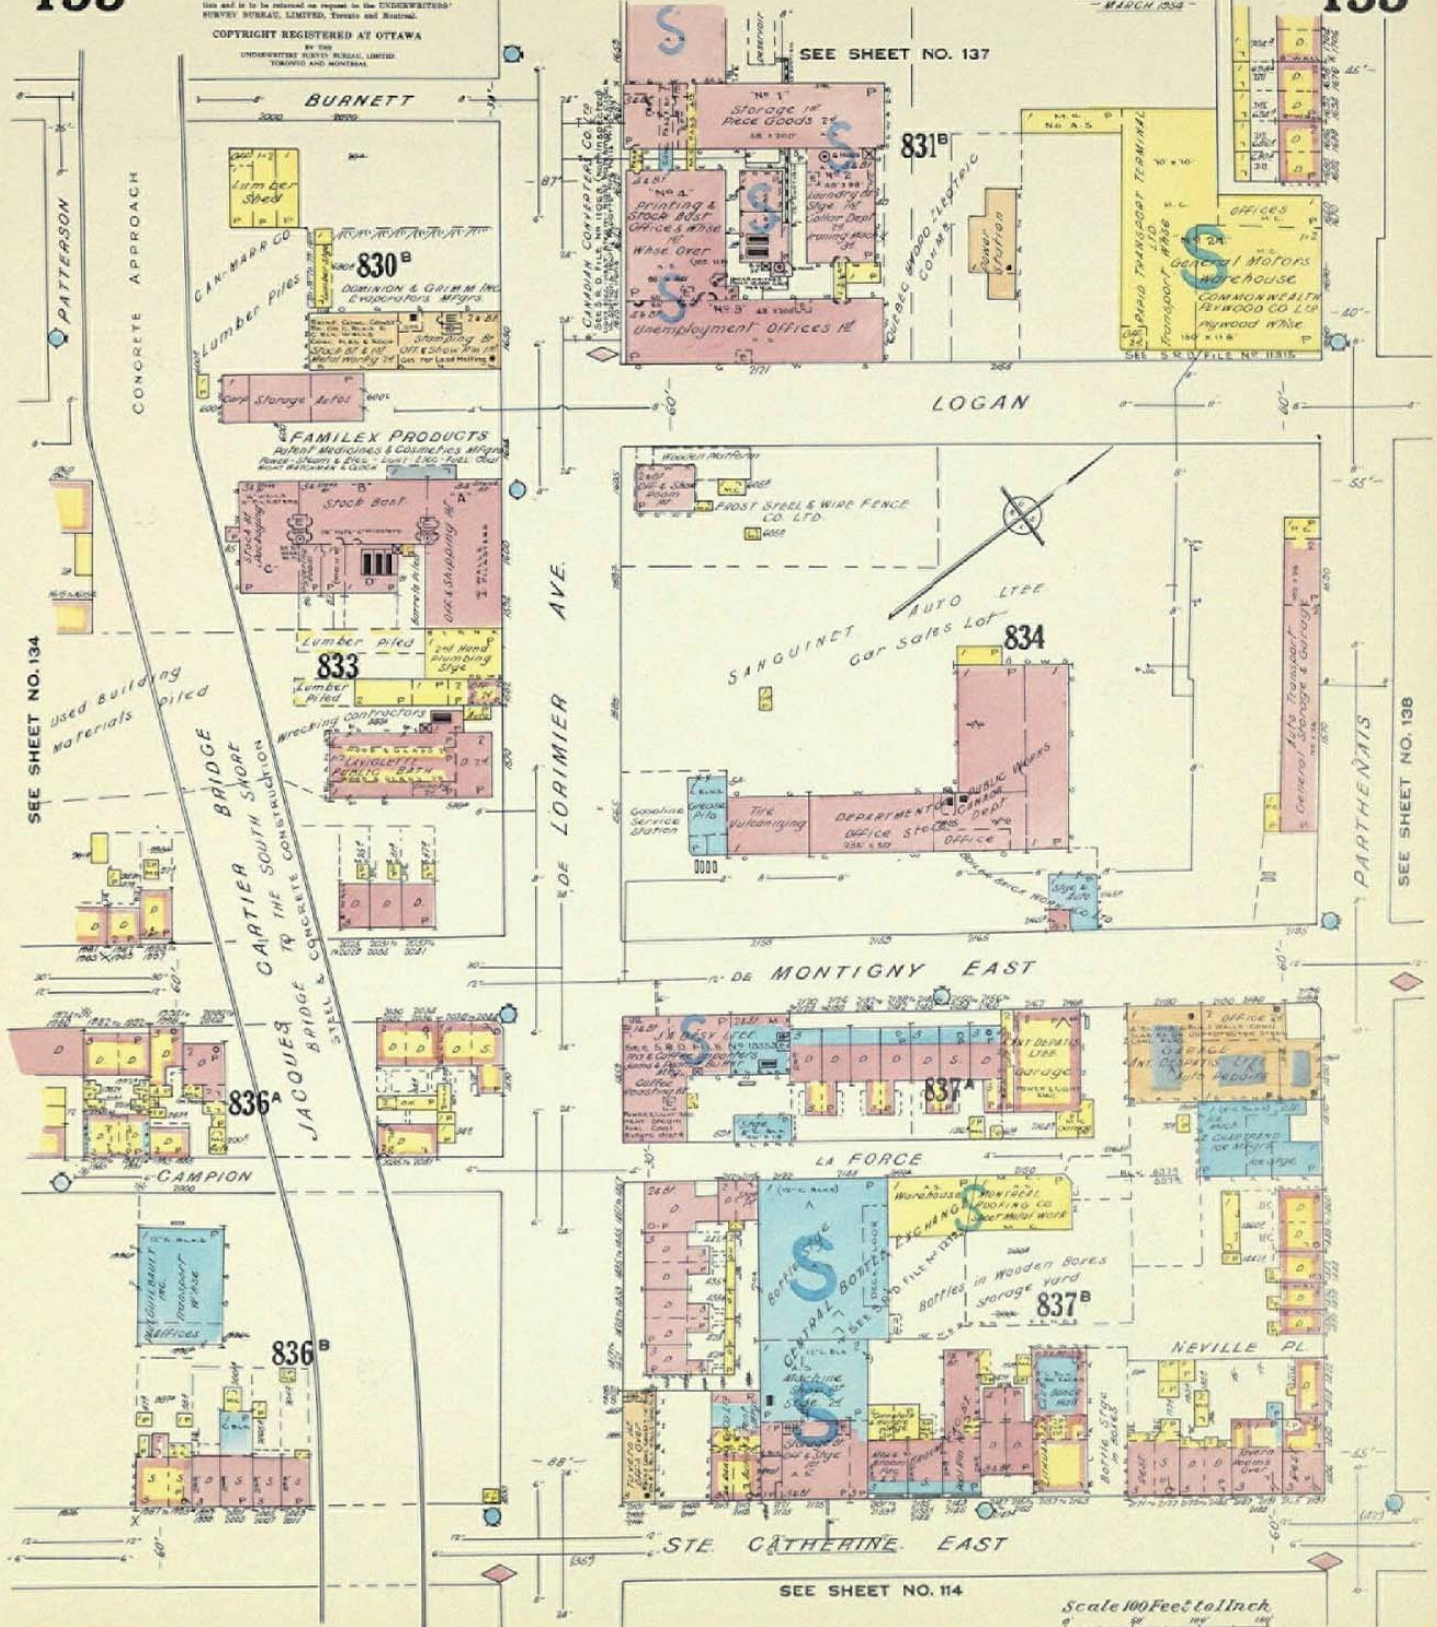

SEE SHEET NO. 114

Scale 100 Feet to 1 Inch

SEE SHEET NO. 134

SEE SHEET NO. 138


137






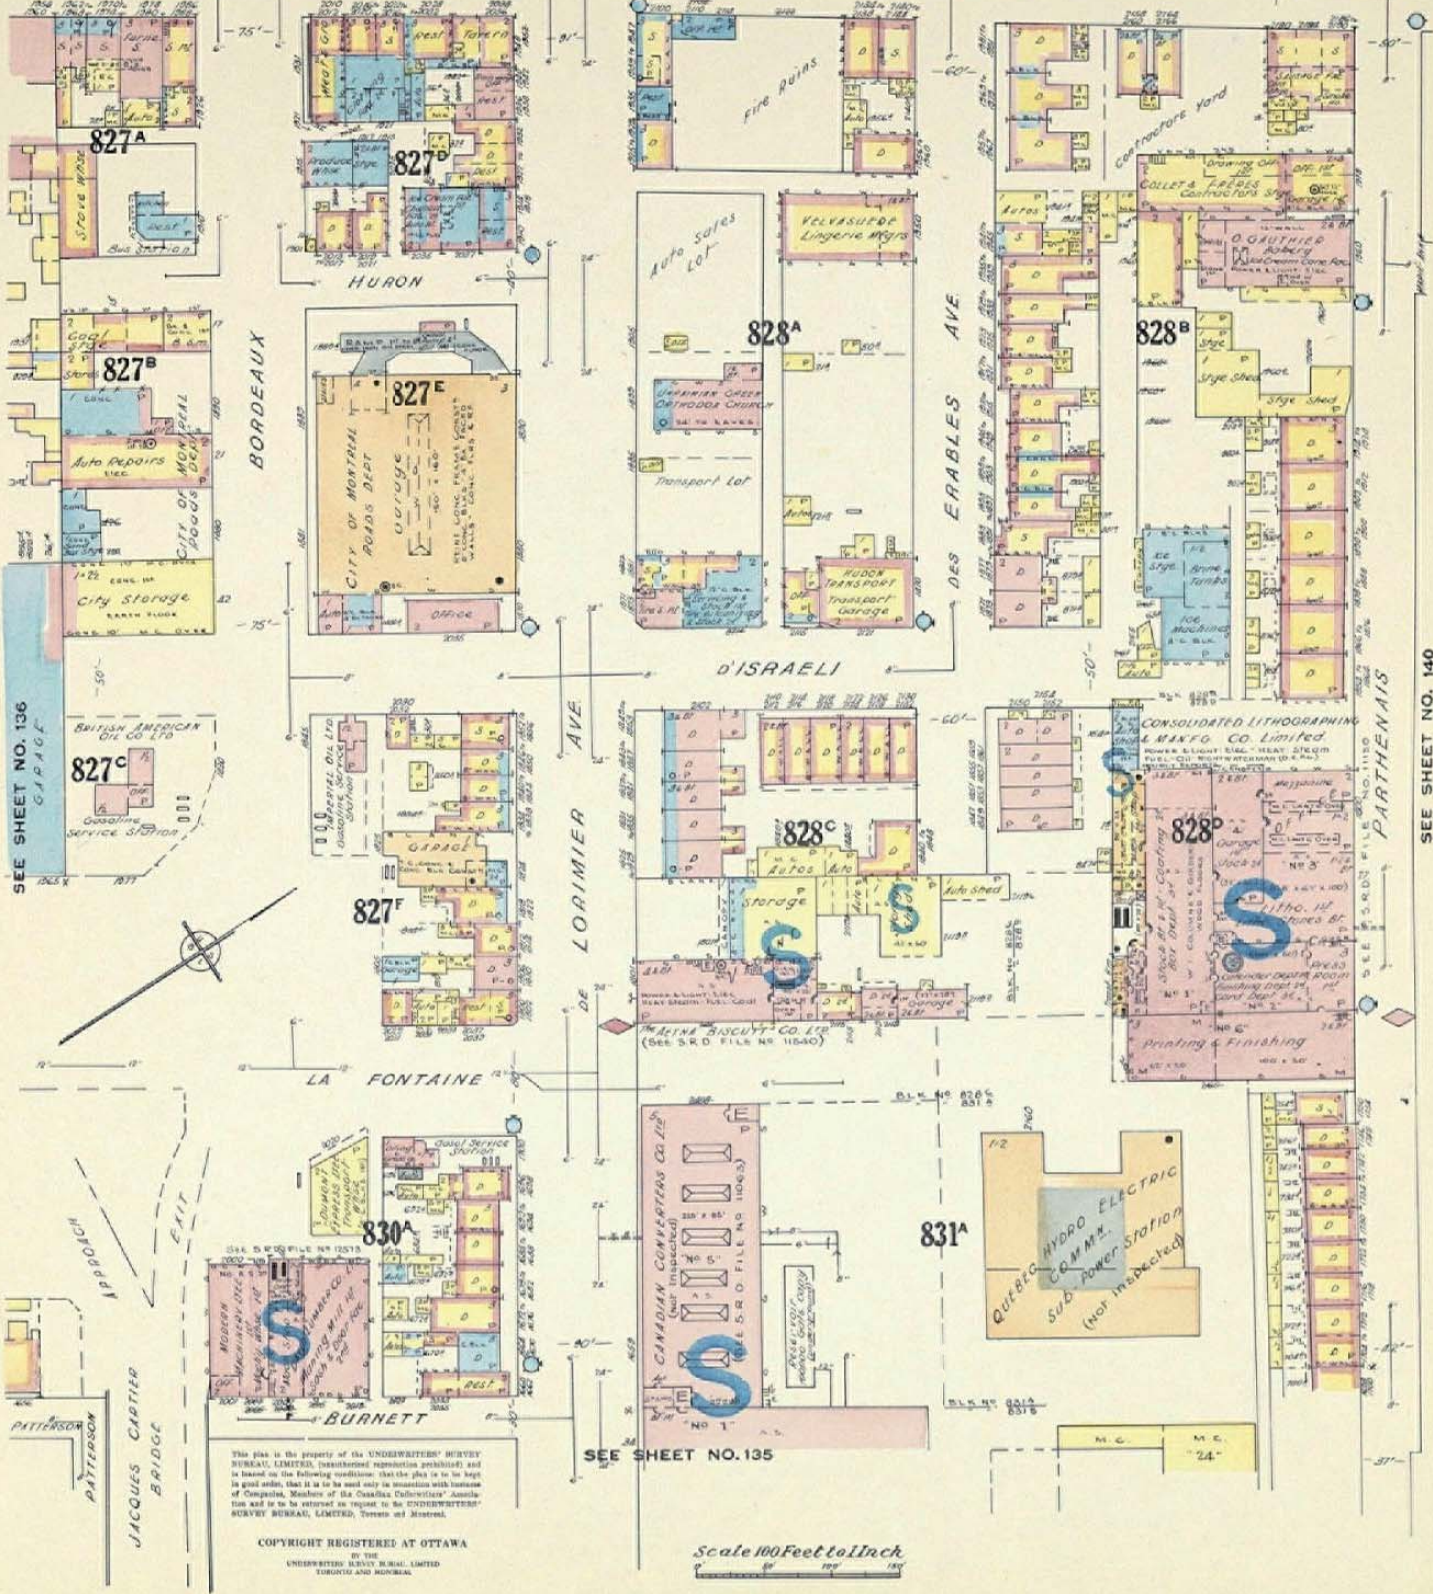

SEE SHEET NO. 136
GARAGE

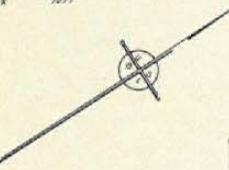



TORONTO AND MONTREAL

SEE SHEET NO. 135

Scale 100 Feet to Inch
1" = 100'

SEE SHEET NO. 140


JACQUES CARTIER
BRIDGE

EXIT

831A
QUEBEC HYDRO ELECTRIC
SUB. POWER STATION
(Not Inspected)

828P
CONSOLIDATED LITHOGRAPHING
& MANFG. CO. Limited
PRINTING & FINISHING

831A
CANADIAN CONVERTERS CO. LTD.
S

830A
S

827C
BRITISH AMERICAN
OIL CO. LTD.
GASOLINE
SERVICE STATION

827F
GARAGE

827E
CITY OF MONTREAL
ROADS DEPT.
OFFICE

827B
CITY OF MONTREAL
ROADS DEPT.
CITY STORAGE

827A
STOVE WORKS
BUS STATION


828A
LINGERIE MFGS.
TRANSPORT LOT
HURON
D'ISRAELI

828B
CONTRACTORS YARD
CITY STORAGE

828P
PRINTING & FINISHING

FIRE RUINS
AUTO SALES LOT


828C
STORAGE
AUTOS

M.C. 24"



ONTARIO EAST

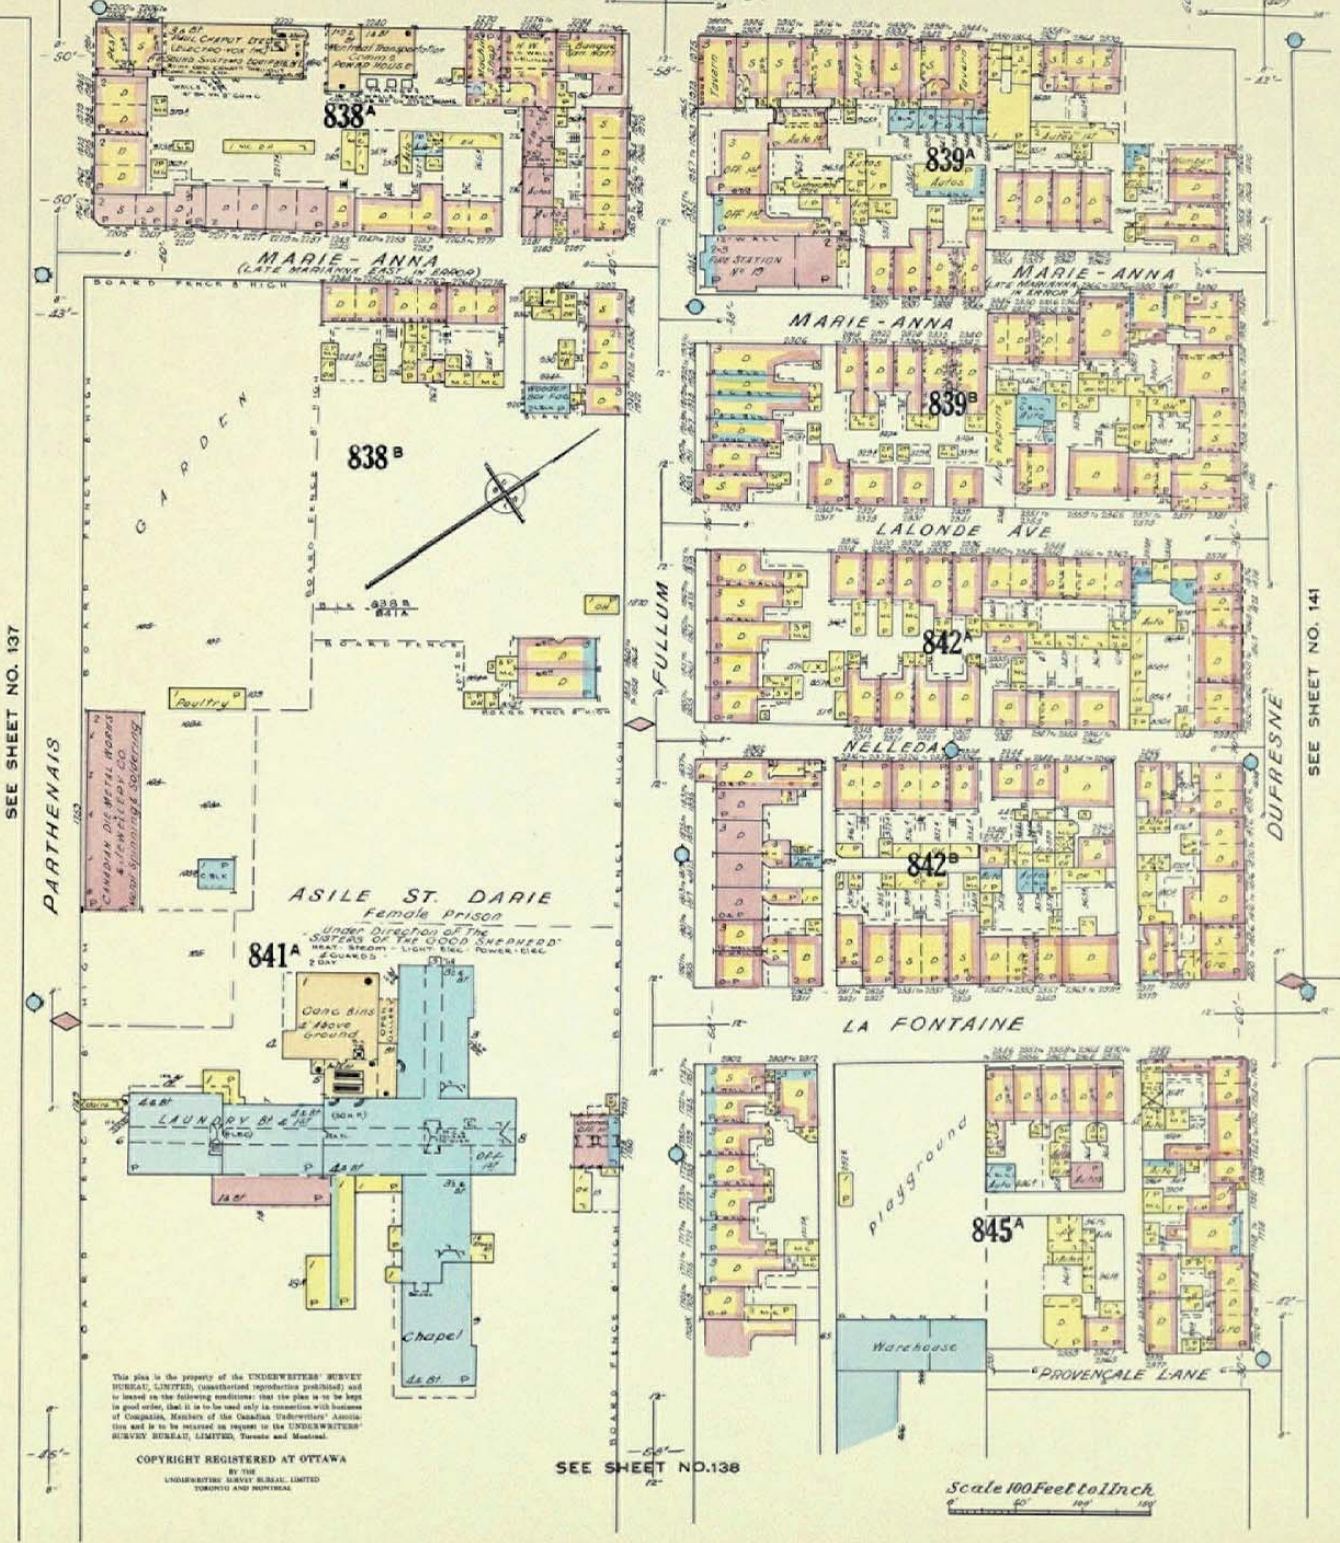

SEE SHEET NO. 137

PARTHENAIS

FULLUM

DUFRESNE

SEE SHEET NO. 141

This plan is the property of the UNDERWRITERS' SURVEY BUREAU, LIMITED, transmission, reproduction prohibited, and is loaned on the following conditions: that the plan is to be kept in good order, that it is to be used only in connection with business of Companies, Members of the Canadian "Underwriters' Association" and it is to be returned on request to the UNDERWRITERS' SURVEY BUREAU, LIMITED, Toronto and Montreal.

COPYRIGHT REGISTERED AT OTTAWA
 BY THE
 UNDERWRITERS' SURVEY BUREAU, LIMITED
 TORONTO AND MONTREAL

SEE SHEET NO. 138

Scale 100 Feet to 1 Inch
 0 50 100