




410

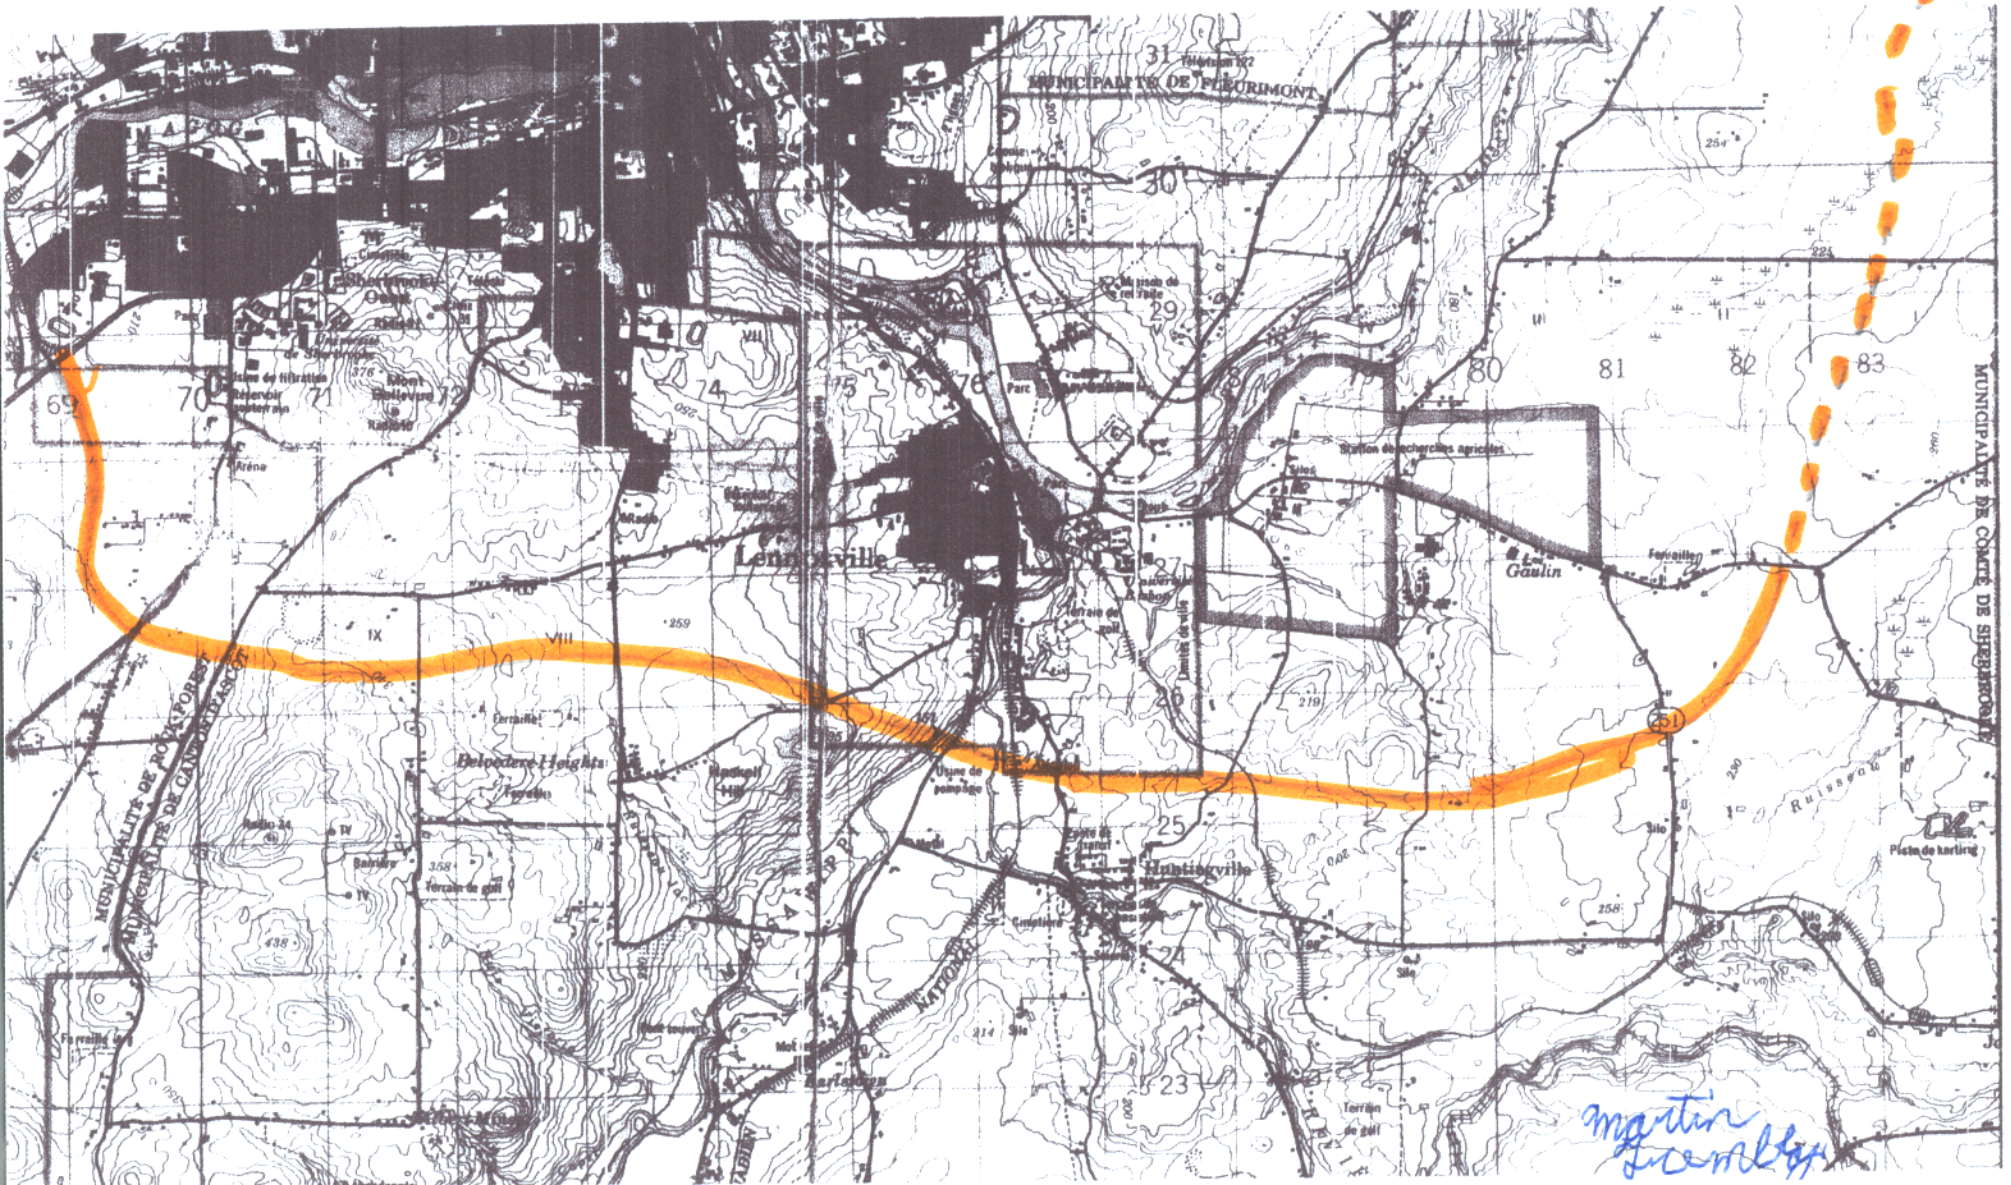

410

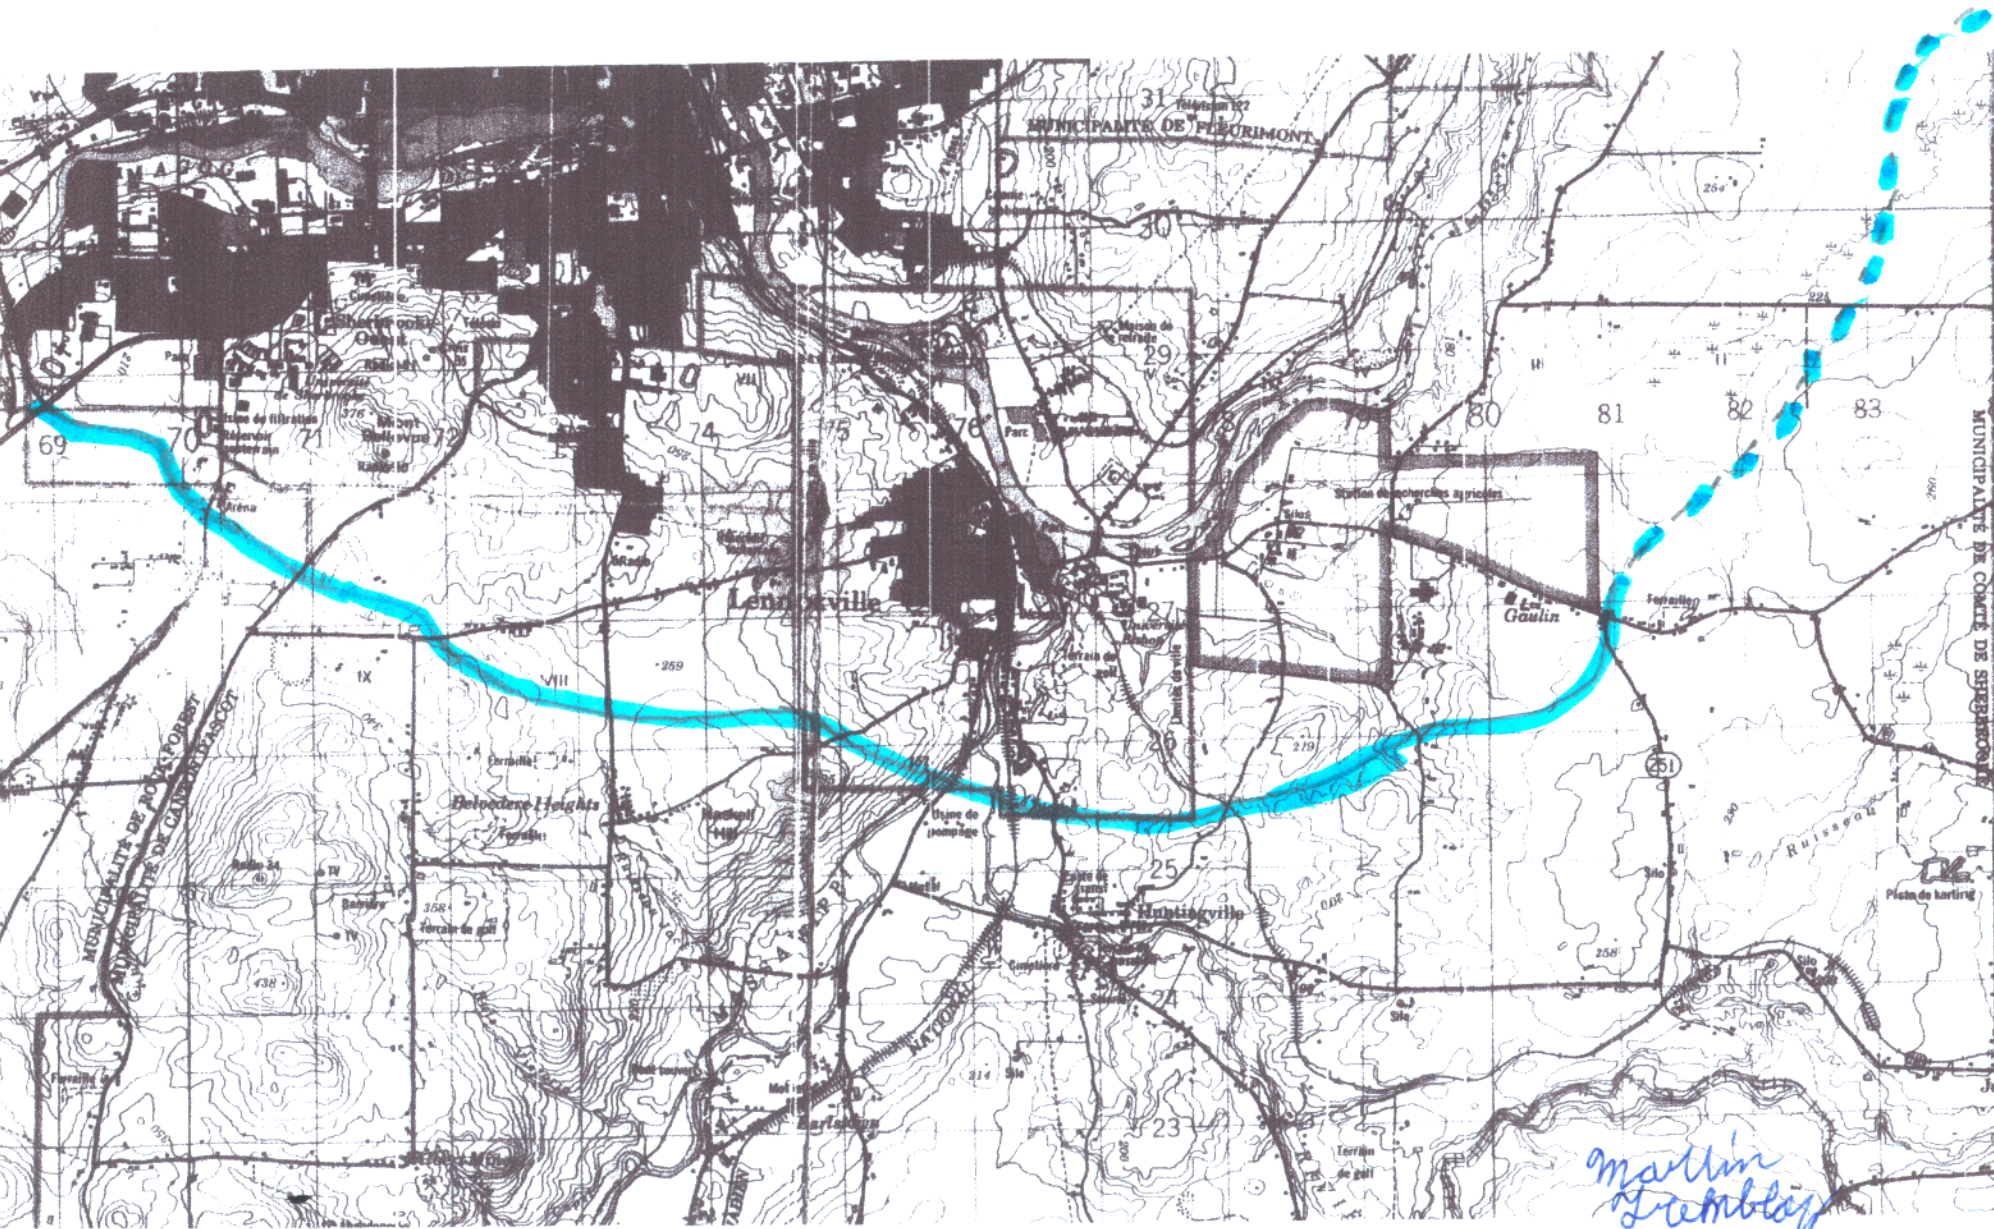

410

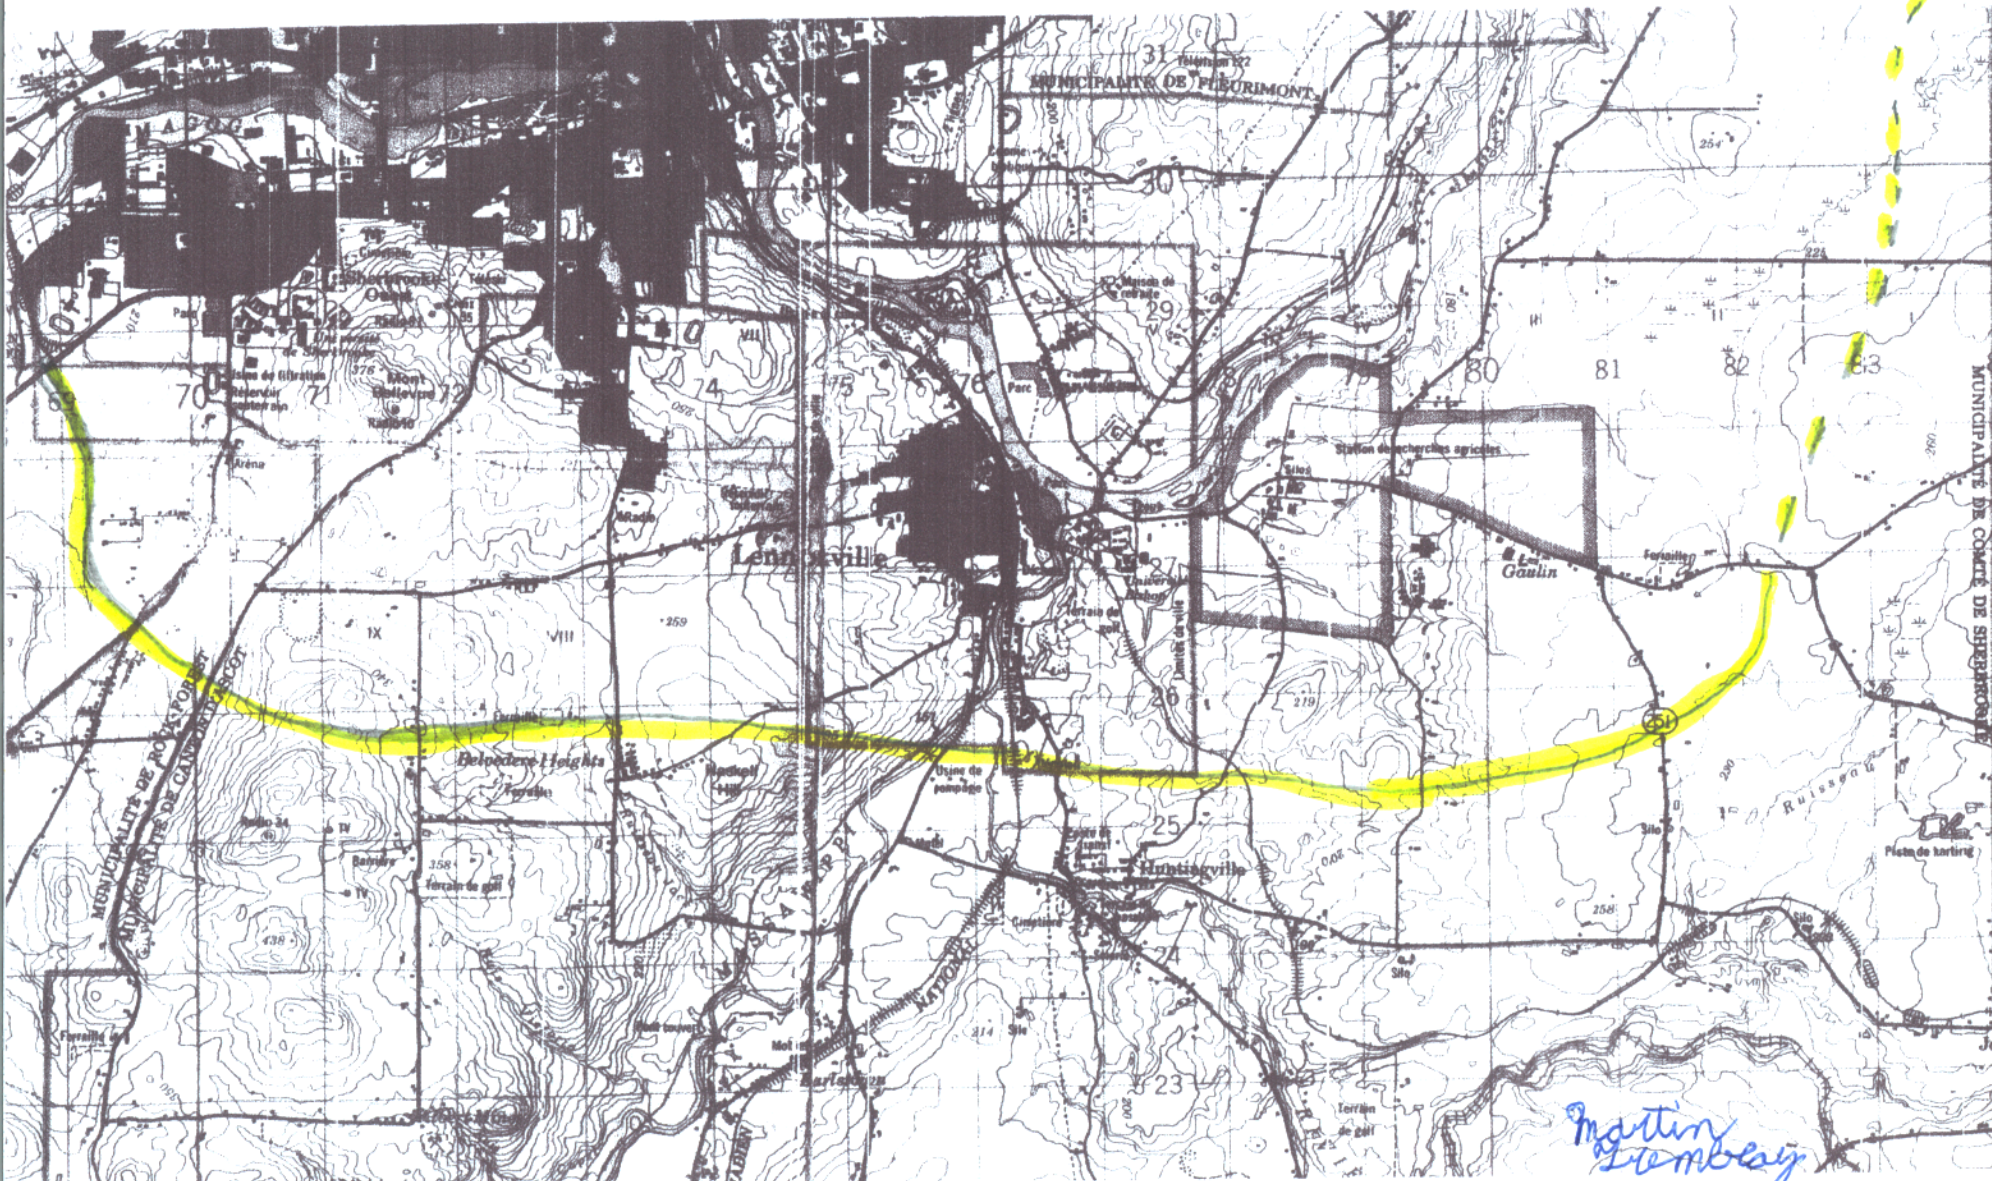

Martin Lemley