

6212-08-001

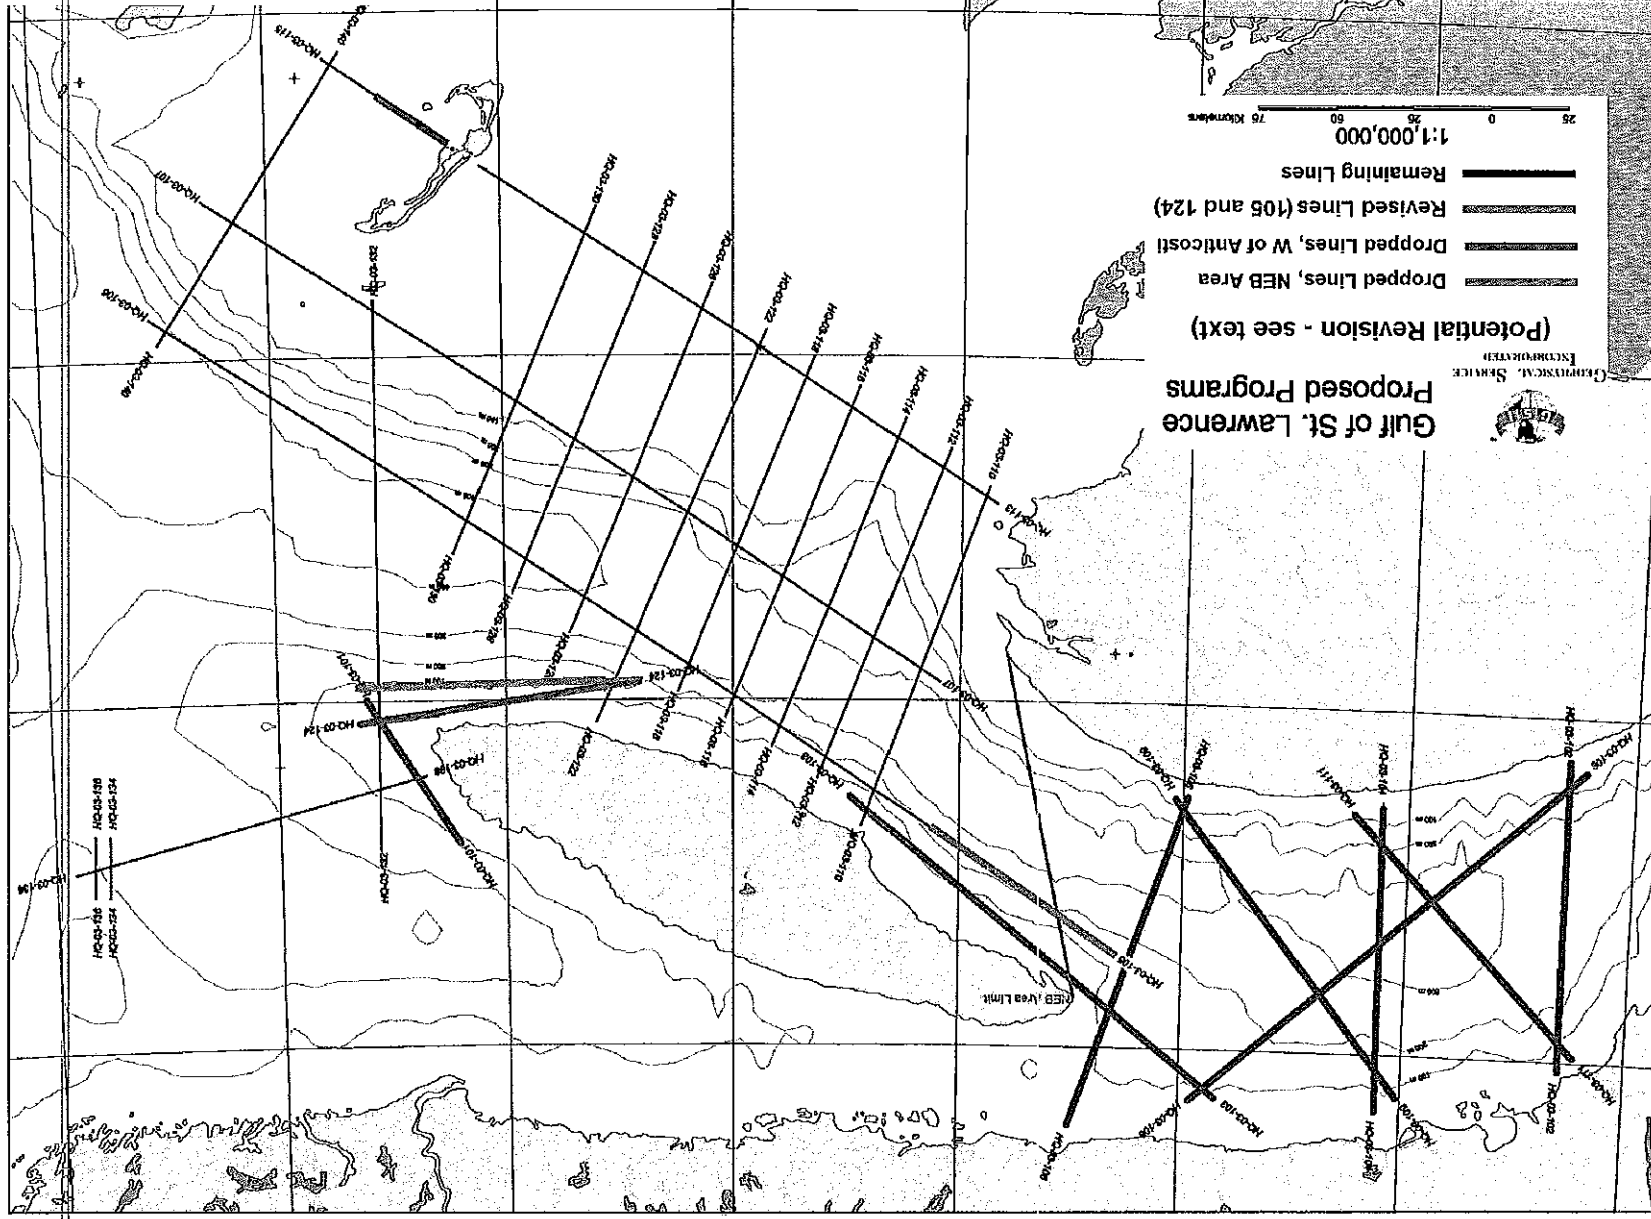


Figure 2: Potential Further Revisions (subject to discussions with DFO - see text)