


Plan 2

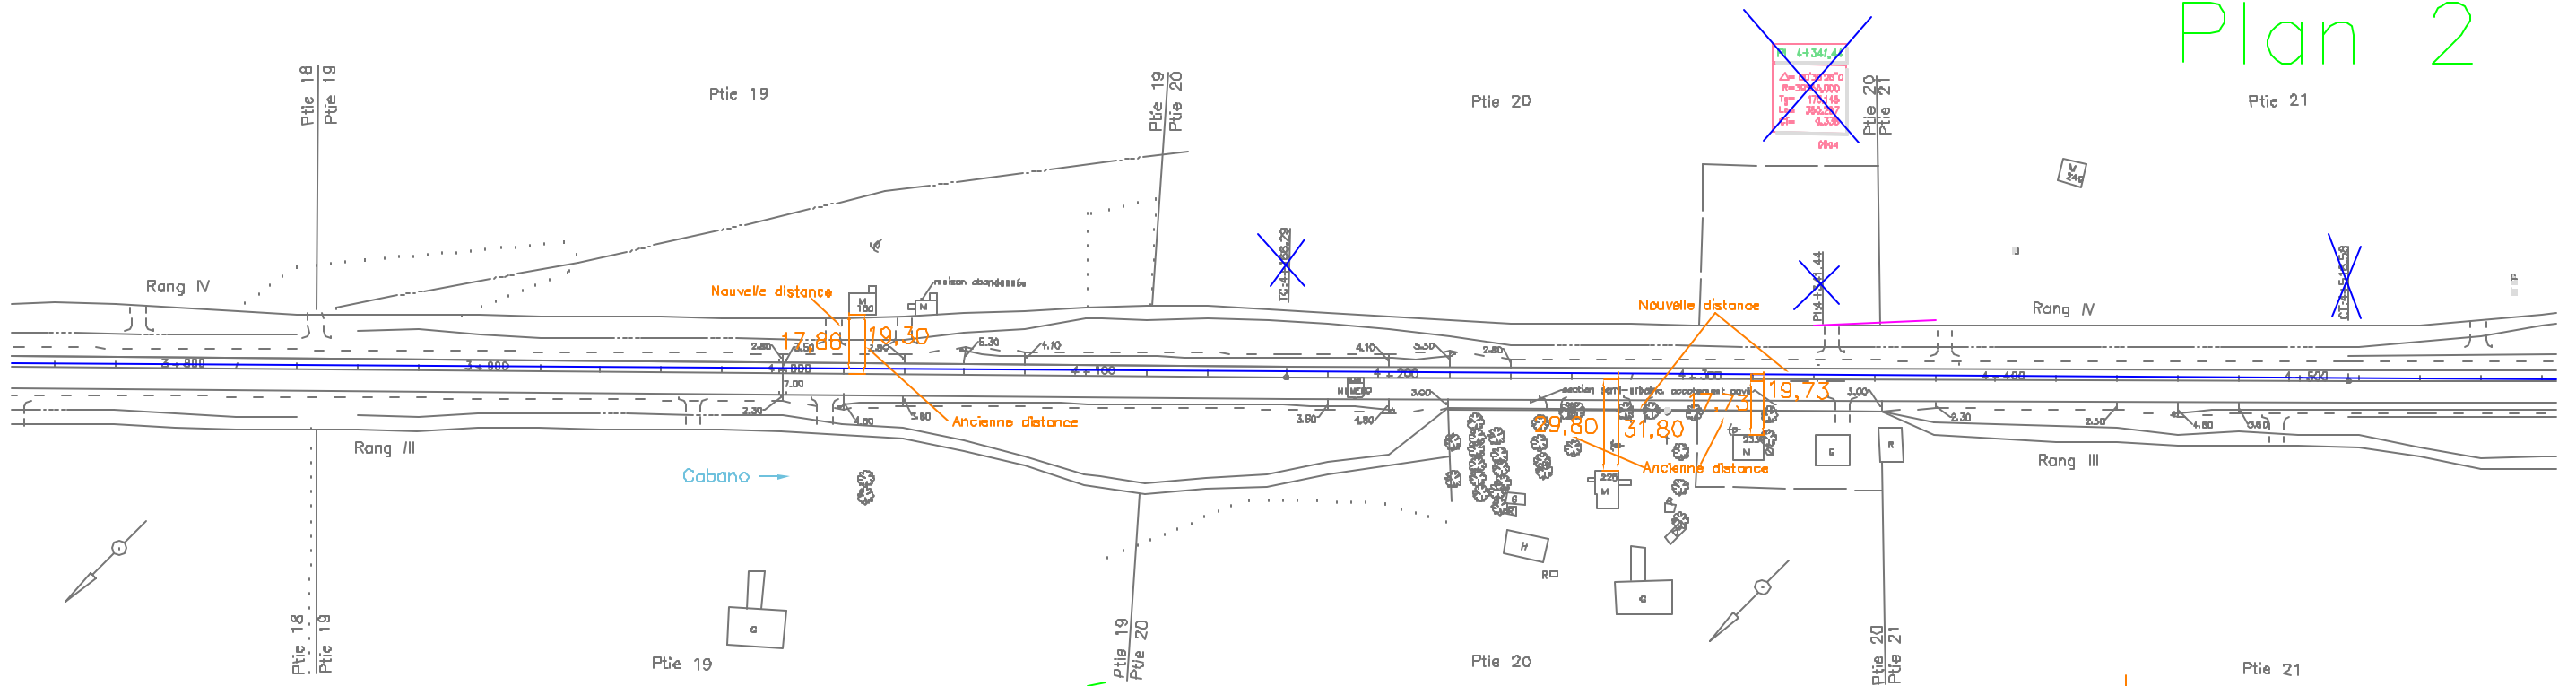

PRÉLIMINAIRE
2002-04-22

