

Tracé original

IDENTIFICATION	CHAÎNAGE	COORDONNÉES	CARACTÉRISTIQUES
①	DR= 1+000.00	X= 211669.829 Y= 5305602.578	G= 383428°38.6"
②	TC= 1+082.00	X= 211889.118 Y= 5305694.529	G= 383428°38.6" Δ= 23428'20.5" R= 1402.292
	PI= 1+383.45	X= 211626.067 Y= 5306683.677	T= 290.831 LC= 573.722
③	CT= 1+666.27	X= 211480.769 Y= 5308235.621	
	TC= 2+181.78	X= 211233.273 Y= 530884.800	G= 330402°09.1" Δ= 113412'41.3" R= 455.000
④	PI= 2+851.08	X= 210899.660 Y= 5307262.842	T= 890.196 LC= 899.041
	CT= 3+060.82	X= 210474.872 Y= 5308710.387	
⑤	TC= 3+213.80	X= 210383.182 Y= 5308597.880	G= 216448°27.0" Δ= 9409'37.5" R= 2220.000
	PI= 3+388.42	X= 210277.821 Y= 5308447.319	T= 175.571 LC= 350.412
⑥	CT= 3+584.26	X= 210151.807 Y= 5308325.087	
	PI= 4+186.15	X= 209719.909 Y= 5308808.964	G= 225444°28.2" Δ= 0407'36.7"
⑦	PI= 4+341.29	X= 209594.472 Y= 5305783.731	G= 225429°14.7" Δ= 0415'13.4"
	PI= 4+518.44	X= 209469.678 Y= 5306600.944	G= 225421°38.0" Δ= 0407'36.7"
⑧	PI= 4+818.13	X= 209183.761 Y= 5305378.702	G= 224459°01.3" Δ= 0422'36.7"
	FR= 0+119.89	X= 208041.134 Y= 5305235.993	G= 224459°01.3"


FACTEUR ECHELLE COMBINÉ 1,00000000

Tracé scénario "D"

IDENTIFICATION	CHAÎNAGE	COORDONNÉES	CARACTÉRISTIQUES
①	DR= 1+000.00	X= 211661.730 Y= 5305549.378	G= 343446°41.8"
②	TC= 1+499.02	X= 211542.328 Y= 5308028.829	G= 343446°41.8" Δ= 13444'32.7" R= 1730.000
	PI= 1+709.80	X= 211483.415 Y= 5306231.015	T= 210.881 LC= 419.739
③	CT= 1+918.78	X= 211378.988 Y= 5308413.708	
	TC= 2+208.71	X= 211233.273 Y= 5308804.800	G= 330402°09.1" Δ= 113412'41.3" R= 455.000
④	PI= 2+888.80	X= 210888.660 Y= 5307262.842	T= 880.196 LC= 899.041
	CT= 3+107.75	X= 210474.872 Y= 5306710.387	
⑤	TC= 3+280.78	X= 210383.182 Y= 5308587.880	G= 216448°27.0" Δ= 9402'37.5" R= 2220.000
	PI= 3+436.35	X= 210277.821 Y= 5306447.319	T= 175.571 LC= 350.412
⑥	CT= 3+611.19	X= 210151.807 Y= 5308325.087	
	PI= 4+213.08	X= 209719.909 Y= 5308803.804	G= 225444°28.2" Δ= 0407'36.7"
⑦	PI= 4+388.22	X= 209594.472 Y= 5305783.731	G= 225429°14.7" Δ= 0415'13.4"
	PI= 4+563.36	X= 209468.678 Y= 5305880.944	G= 225421°38.0" Δ= 0407'36.7"
⑧	PI= 4+863.03	X= 209183.761 Y= 5305378.702	G= 224459°01.3" Δ= 0422'36.7"
	FR= 5+166.81	X= 208041.134 Y= 5305235.993	G= 224459°01.3"

FACTEUR ECHELLE COMBINÉ 1,00000000

SCÉNARIO "D"

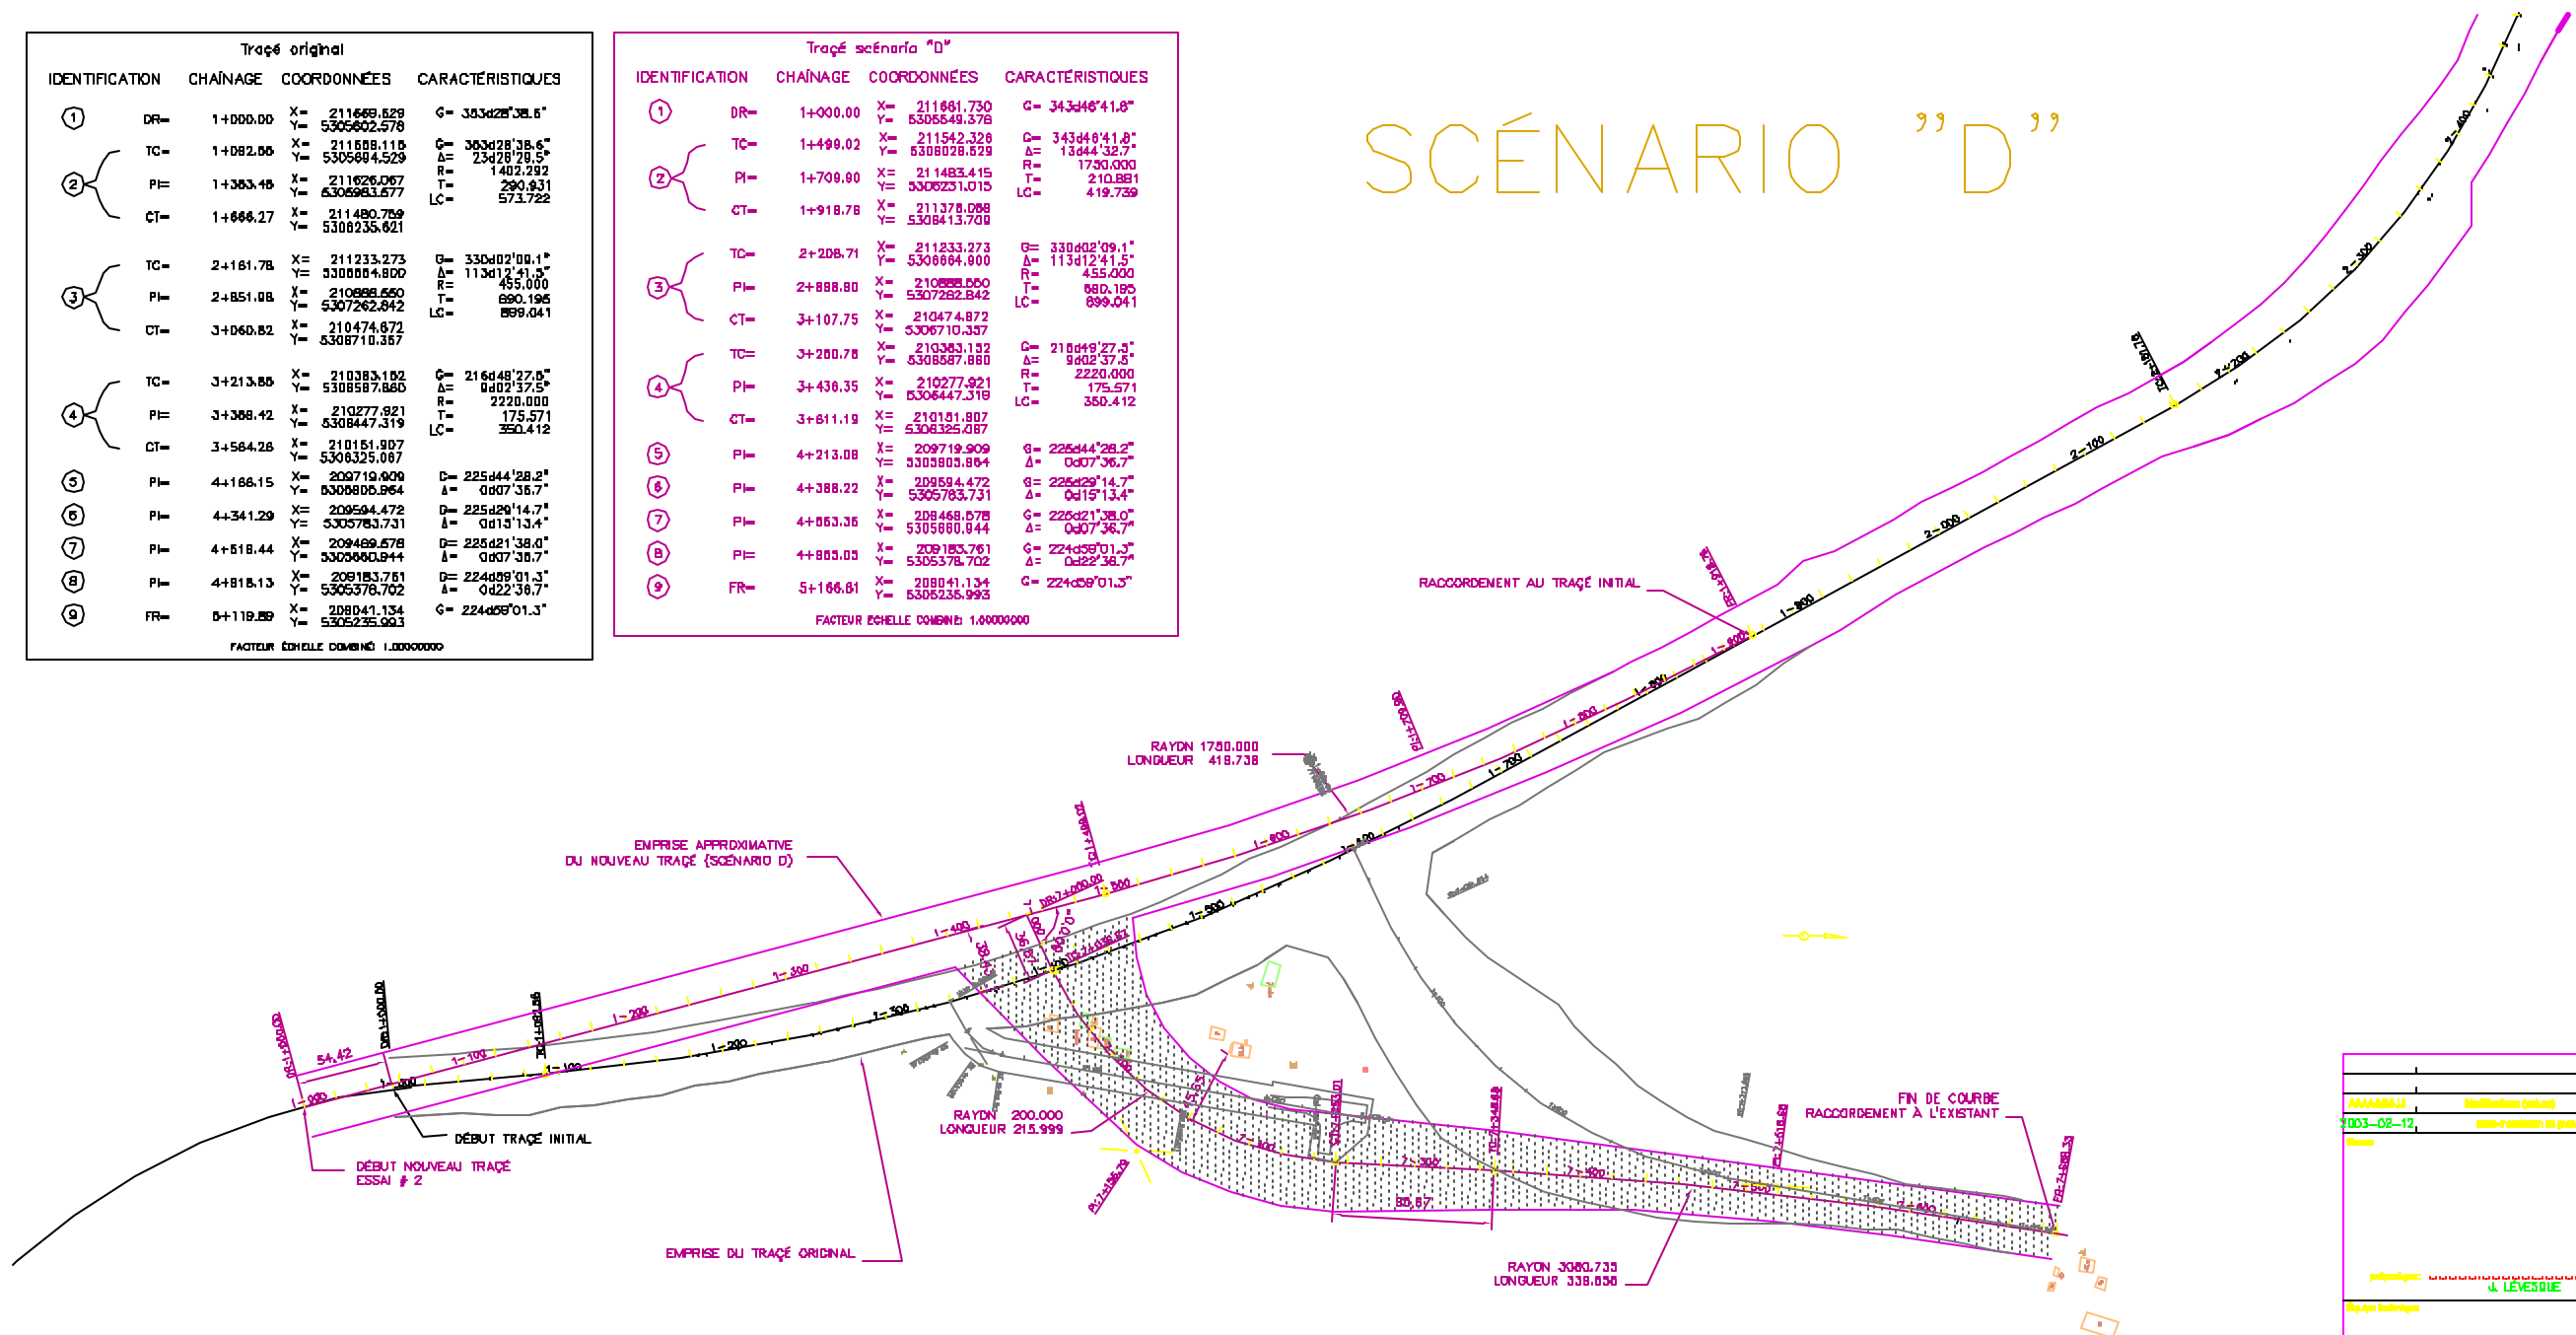

ESSAI # 2 VERS LAC-DES-AGILES

IDENTIFICATION	CHAÎNAGE	COORDONNÉES	CARACTÉRISTIQUES
①	DR= 7+000.00	X= 211006.020 Y= 5305961.460	G= 63646°41.8"
②	TC= 7+036.67	X= 211088.818 Y= 5305987.883	G= 63646°41.8" Δ= 81459'38.8" R= 200.000
	PI= 7+156.79	X= 211088.818 Y= 5306060.737	T= 120.117 LC= 216.340
③	CT= 7+253.01	X= 211700.480 Y= 5306170.784	
	TC= 7+348.88	X= 211703.457 Y= 5308288.414	G= 1448°04.8" Δ= 8419'01.0" R= 3080.733
④	PI= 7+518.88	X= 211708.801 Y= 5306456.330	T= 170.000 LC= 339.686
	FR= 7+888.33	X= 211732.808 Y= 5308804.828	

FACTEUR ECHELLE COMBINÉ 1,00000000

Transports Québec
 Direction Générale de Québec et de l'Est
 Direction du Bas-Saint-Laurent-Gaspésie-Iles-de-la-Madeleine
 Service des Projets
SAINT-MICHEL-DU-SQUATEC
 RÉAMÉNAGEMENT INTERSECTION ROUTE 232 ET 295
 SCÉNARIO "D"